

MAR 17 2000

FILED

SECTION

LAND CORNER RECORDATION CERTIFICATE
Filing Requirement of Act 74, Mich. P.A. 1970

For corners in

1999 MAY 21 A 9:22

<u>LIVINGSTON</u> (County)	Located In:	Corner Code #
1. Public Land Survey	<u>T 3 N R 4 E</u>	<u>K-07</u>
	T <u> </u> R <u> </u>	<u> </u>
	T <u> </u> R <u> </u>	<u> </u>
	T <u> </u> R <u> </u>	<u> </u>
2. Property Controlling in Section	S <u> </u> T <u> </u> R <u> </u>	<u> </u>
	S <u> </u> T <u> </u> R <u> </u>	<u> </u>
3. Miscellaneous Property in Sec.	S <u> </u> T <u> </u> R <u> </u>	<u> </u>
	S <u> </u> T <u> </u> R <u> </u>	<u> </u>

NANCY HAVILAND
REGISTER OF DEEDS
LIVINGSTON COUNTY, MI.
48843

L.S.C.#1011m

Register of Deeds Stamp & File Number

- 4. Lot No. _____, Recorded Plat _____
- 5. Private Claims _____

I, JACK K SMITH, in a field survey on APRIL 30, 1999, do hereby state that under requirements of P.A. 74, Michigan P.A. of 1970, the corner points mentioned in lines 1 and 2 above were in conformance with regulations and rules therefore as required in the current manual of survey instructions of the United States Department of the Interior, Bureau of Land Management or by a decree of a Court of Law and/or that the corner points mentioned in lines 3, 4 and 5 above were in conformance with the rules of the Michigan Board of Land Surveyors or by a Decree of a Court of Law; established, re-established, monumented, recovered, found as expressed below:

NOTE: Not more than 2 corners, all in the same town and range, may be recorded on this certificate.

	A	B	C	D	E	F	G	H	I	J	K	L	M
1													
2	6		5		4		3		2		1		
3													
4	7		8		9		10		11		12		
5													
6	18		17		16		15		14		13		
7													
8	19		20		21		22		23		24		
9													
10	30		29		28		27		26		25		
11													
12	31		32		33		34		35		36		
13													

A. Description of original monument and accessories and/or subsequent restoration:

GLO 1825 SIBLEY SET POST
WHITE OAK 20 N 52° W 9.9'
BLACK OAK 13 S 86° E 19.2'

B. Description of corner evidence found and/or method applied in restoring or reestablishing corner:


FOUND PK NAIL OVER BOAT SPIKE IN MONUMENT BOX FROM PREVIOUS WITNESSES. THIS POSITION IS THE ONLY ONE THAT APPEARS TO HAVE BEEN USED.

C. Description of monument for corner and accessories established to perpetuate locating the position of the corner:

K-07 CORNER COMMON TO SECTIONS 13, 14, 23 AND 24, T3N, R4E, HOWELL TOWNSHIP, LIVINGSTON COUNTY, MICHIGAN:
SET 1 1/4" X 36" STEEL PIPE WITH 6" BREAK OFF SECTION AND LIVINGSTON COUNTY REMONUMENTATION BRASS CAP WITH SURVEYOR #35999 IN MONUMENT BOX 5.5 FEET WEST OF CENTER LINE OF OAK GROVE ROAD.

N40°W CENTER LINE OF 16" FORKED SPRUCE
WEST NAIL WITH LIVINGSTON COUNTY REMON TAG IN SOUTH SIDE UTILITY POLE
S40°W NAIL WITH LIVINGSTON COUNTY REMON TAG IN NORTH SIDE 16" WALNUT
S30°W NAIL WITH LIVINGSTON COUNTY REMON TAG IN NORTH SIDE 15" WALNUT

67.40'
23.22'
35.67'
56.40'

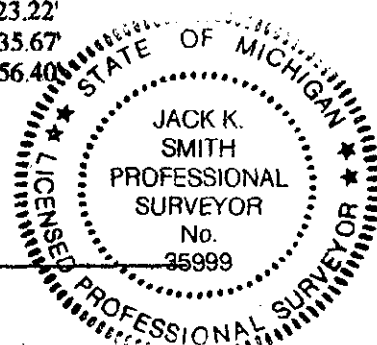

Signed by [Signature]

Date 5-12-1999

Surveyor's Michigan License No. 35999

PA. 245 1990, APPROVED BY LIVINGSTON COUNTY
PEER GROUP ON 4-7-1999 CO. REP VED