


## CORNER SUMMARY

K-10: WEST 1/4 CORNER OF SECTION 25, T3N-R4E, HOWELL TOWNSHIP,  
LIVINGSTON COUNTY, MICHIGAN.

GLO SURVEY DATED APRIL 15, 1996 BY S SIBLEY AND NONE OF THE GLO  
WITNESSES REMAIN.

M BULLOCK HAD WITNESSED THE CORNER IN 1874 AND THEY ARE GONE,  
SINCE THEN ALL OTHER WITNESSES PRIOR TO THE CONSTRUCTION OF M-59  
IN THE '50S ARE GONE EXCEPT THOSE TO THE REYHL HOUSE AND THEY CHECK.  
SINCE 1953 MANY OF THE WITNESSES BY L MUNSELL, P. BENTON, BOSS ENGR  
C NEWMAN, DESINE, CHMP, AND MYSELF ARE TO THE SAME POINTS AND THEY  
CHECK. MEASURES WEST ARE 2649.86 BY DESINE, 2649.91 BY BOSS AND  
2649.79 BY NEWMAN. MEASURE NORTH OF 2658.10 BY BOSS,  
MEASURE EAST OF 2671.76 BY BOSS AND MEASURE SOUTH, 2647.95 BY  
MYSELF, 2647.93 BY C NEWMAN AND A COMBINATION OF MEASURES BY  
DUNNING AND GORDON OF 2645.93. THE FOUND 3/4" I. PIPE LINES WITH  
AN OLD FENCE AND TREE LINE TO THE NORTH. TWO ACT 74'S ARE  
RECORDED AND FOUR ACT 132'S. CORNER IS LOCATED IN AN ENTRANCE  
ISLAND TO APARTMENTS JUST NORTH OF SOME SCRUBS, MIGHT BE A  
POSSIBLE GPS SITE.



CHARLES E. GARLOCK  
PS 14762  
HOW96K10

7/14/96  
T

**LAND CORNER RECORDATION CERTIFICATE**  
**Filing Requirement of Act 74, Mich. P.A. 1970**

For corners in

Livingston (County) Located In: Corner Code ≠#

1. Public Land Survey	T <u>3N</u> R <u>4E</u>	<u>K-11</u>
	T _____ R _____	_____
	T _____ R _____	_____
	T _____ R _____	_____
2. Property Controlling in Section	S _____ T _____ R _____	_____
	S _____ T _____ R _____	_____
3. Miscellaneous Property in Sec.	S _____ T _____ R _____	_____
	S _____ T _____ R _____	_____

NANCY HAVILLAND  
 REGISTER OF DEEDS  
 LIVINGSTON COUNTY, MI  
 48843

SEP 1 3 29 PM '94

FILED

L.S.C. # 249m

Register of Deeds Stamp & File Number

4. Lot No. \_\_\_\_\_, Recorded Plat \_\_\_\_\_  
 5. Private Claims \_\_\_\_\_

I, Charles E. Garlock, in a field survey on August 25, 19 94, do hereby certify that under requirements of P.A. 74, Michigan P.A. of 1970, the corner points mentioned in lines 1 and 2 above were in conformance with regulations and rules therefore as required in the current manual of survey instructions of the United States Department of the Interior, Bureau of Land Management or by a decree of a Court of Law and/or that the corner points mentioned in lines 3, 4 and 5 above were in conformance with the rules of the Michigan Board of Land Surveyors or by a Decree of a Court of Law; established, re-established, monumented, re-monumented, recovered, found as expressed below:

**NOTE: Not more than 4 corners, all in the same town and range, may be recorded on this certificate.**

	A	B	C	D	E	F	G	H	I	J	K	L	M
2	6	5	4	3	2	1							
3													
4	7	8	9	10	11	12							
5													
6	10	17	16	15	14	13							
7													
8	19	20	21	22	23	24							
9													
10	30	29	28	27	26	25							
11													
12	31	32	33	34	35	36							
13													

A. Description of original monument and accessories and/or subsequent restoration:  
 GLO survey date: April 15, 1825, S Sibley, DS  
 GLO witnesses: W014-N62W-0.95 ch  
B013-S65E-0.47 ch

See additional data on rear of sheet


B. Description of corner evidence found and/or method applied in restoring or reestablishing corner:  
 Road intersection recently rebuilt and found no iron. Re-established corner from previous witnesses, and 3 property surveys previously referenced to said corner: "McPherson-Browning Sub" in 1927 by GH Dunning, "Assessor's Plat No. 3" to City of Howell, MI in 1940 by C W Gordon and McPherson Estate survey of unplatted land in SE 1/4 of Section 26, Howell Twp. in 1973 by Charles E Garlock.

**SURVEY &  
 REMONUMENTATION**

SEP 26 1994

COMMISSION

C. Description of monument for corner and accessories established to perpetuate locating the position of the corner:  
 K-11: NW cor. Sec. 36 T3N-R4E, Howell Twp. Liv. Co. MI; replaced temp. PK spike with 1 1/4" X 36" I. Pipe with breakaway top and Liv. Co. Remon brass cap on top, in set Mon Box.  
 S45W-31.13'-Sp & tag E/s U. Pole  
 N40W-62.66'-Sp & tag E/s 20" maple  
 N50E-46.69'-sp & tag NW/s 10" Maple  
 S55E-96.44'-NW cor. House Fdn.  
 North-16.62'-nearest edge Water gate valve box  
 S70W-6.02'-nearest edge Manhole rim  
 N50E-10.43'- " " " "

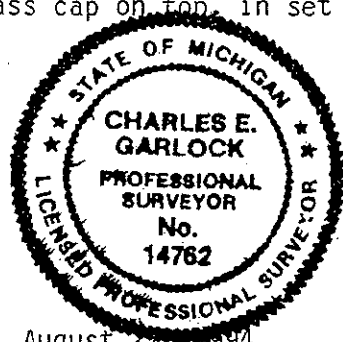

Signed by Charles E. Garlock Date August 27, 1994

Surveyor's Michigan License No. 14762

FORM APPROVED BY MICHIGAN STATE BOARD OF LAND SURVEYORS, JAN. 28, 1971  
 REVISED MAY 14, 1975  
 REVISED JAN., 1983

P.A. 345 1990, APPROVED BY LIVINGSTON COUNTY  
 PEER GROUP ON 18 May 94 CO. REP Rabb