

OCT 25 1993

OCT 12 10 18 AM '93

COMMISSION

LAND CORNER RECORDATION CERTIFICATE
Filing Requirement of Act 74, Mich. P.A. 1970

NANCY HAVILAND
REGISTER OF DEEDS
LIVINGSTON COUNTY, MI
48843

For corners in

Livingston

(County)

Located in:

Corner Code =#

1. Public Land Survey

T 3N R 4E

L-13

T _____ R _____

T _____ R _____

T _____ R _____

T _____ R _____

2. Property Controlling
in Section

S _____ T _____ R _____

S _____ T _____ R _____

3. Miscellaneous
Property in Sec.

S _____ T _____ R _____

S _____ T _____ R _____

4. Lot No. _____, Recorded Plat _____

5. Private Claims _____

L.S.C.# 17m

Register of Deeds Stamp & File Number

I, Charles E Garlock, in a field survey on September 8, 19 93, do hereby certify that under requirements of P.A. 74, Michigan P.A. of 1970, the corner points mentioned in lines 1 and 2 above were in conformance with regulations and rules therefore as required in the current manual of survey instructions of the United States Department of the Interior, Bureau of Land Management or by a decree of a Court of Law and/or that the corner points mentioned in lines 3, 4 and 5 above were in conformance with the rules of the Michigan Board of Land Surveyors or by a Decree of a Court of Law; established, re-established, monumented, re-monumented, recovered, found as expressed below:

NOTE: Not more than 4 corners, all in the same town and range, may be recorded on this certificate.

A. Description of original monument and accessories and/or subsequent restoration:

GL0 notes dated: April 15, 1825

GL0 witnesses: Apsin 14-East-5.56 ch

Elm 13-N89W-9.74 ch

Additional historical data on back of sheet.

B. Description of corner evidence found and/or method applied in restoring or reestablishing corner:

Found 4" dia Conc. Mon. with 1/2" I. Rod at SW corner of Assessor's Plat No. 7 to Village (now City) of Howell, recorded Liber 4 plats, page 38 LCR and at NW corner of Fowler Heights, recorded Liber 22, pages 30 -32 LCR.

C. Description of monument for corner and accessories established to perpetuate locating the position of the corner:

Set brass cap on top of found Conc. Mon.

S5W-9.90'-sp W/s 15" Elm

S85W-86.41'-NE corner of Utility Bldg.

North-38.78'-sp W/s 18" Box Elder

S15E-129.11'-NW corner of House


North-156.88'-"+ in SE corner Manhole rim.

Approved by Livingston County Monumentation Peer Group August 18, 1993

Signed by Charles E Garlock

Date October 9, 1993

Surveyor's Michigan License No. 14762

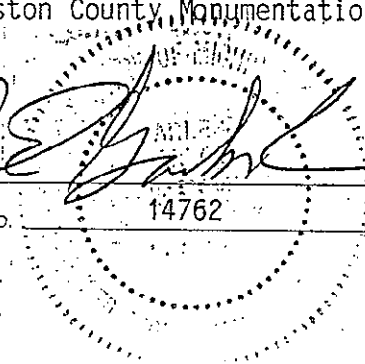

	A	B	C	D	E	F	G	H	I	J	K	L	M
2	6	5	4	3	2	1							
3													
4	7	8	9	10	11	12							
5													
6	18	17	16	15	14	13							
7													
8	19	20	21	22	23	24							
9													
10	30	29	28	27	26	25							
11													
12	31	32	33	34	35	36							
13													

10/26/93