

FILED

7

LAND CORNER RECORDATION CERTIFICATE
Filing Requirement of Act 74, Mich. P.A. 1970

DEC 22 9 27 AM '93

NANCY HAVILAND
REGISTER OF DEEDS
LIVINGSTON COUNTY, MI
48843

For corners in
LIVINGSTON
(County)

Located In: Corner Code #/

- 1. Public Land Survey T 3N R 4E M-1
T _____ R _____
T _____ R _____
T _____ R _____
- 2. Property Controlling S _____ T _____ R _____
in Section S _____ T _____ R _____
- 3. Miscellaneous S _____ T _____ R _____
Property in Sec. S _____ T _____ R _____
- 4. Lot No. _____, Recorded Plat _____
- 5. Private Claims _____

L.S.C.# 73m

Register of Deeds Stamp & File Number

I, Donald G. Richards in a field survey on October 19, 1993, 19_____, do hereby certify that under requirements of P.A. 74, Michigan P.A. of 1970, the corner points mentioned in lines 1 and 2 above were in conformance with regulations and rules therefore as required in the current manual of survey instructions of the United States Department of the Interior, Bureau of Land Management or by a decree of a Court of Law and/or that the corner points mentioned in lines 3, 4 and 5 above were in conformance with the rules of the Michigan Board of Land Surveyors or by a Decree of a Court of Law; established, re-established, monumented, re-monumented, recovered, found as expressed below:

NOTE: Not more than 4 corners, all in the same town and range, may be recorded on this certificate.

- A. Description of original monument and accessories and/or subsequent restoration:
White Oak 14 N 27 E 44
White Oak 16 S 64 W 61


	A	B	C	D	E	F	G	H	I	J	K	L	M
2	6		5		4		3		2		1		
3													
4	7		8		9		10		11		12		
5													
6	18		17		16		15		14		13		
7													
8	19		20		21		22		23		24		
9													
10	30		29		28		27		26		25		
11													
12	31		32		33		34		35		36		
13													

SURVEY &
REMONUMENTATION

1993

COMMISSION

- B. Description of corner evidence found and/or method applied in restoring or reestablishing corner:
Found 1/2" Iron Rod

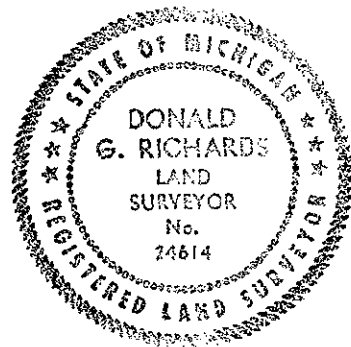

- C. Description of monument for corner and accessories established to perpetuate locating the position of the corner:

Re-set with 1 1/4" x 36" iron pipe w/brass cap stamped "Livingston County Remonumentation Corner"
S 35 W 63.12' 1" iron reference pipe w/brass cap stamped "Livingston County Witness Point"
N 45 W 49.08' 1" iron reference pipe w/brass cap stamped "Livingston County Witness Point"
N 40 E 54.06' nail/LCWT* in W face 24" Maple
S 45 E 60.11' 1" iron reference pipe w/brass cap stamped "Livingston County Witness Point"
(* Livingston County Witness Tag)

Signed by DONALD G. RICHARDS *[Signature]* Date December 10, 1993

Surveyor's Michigan License No. 24614
Corner M-13 T4N-R4E APPROVED by Livingston County Monumentation
Peer Group 11-23-93

JUL 16 1997

COMMISSION

LAND CORNER RECORDATION CERTIFICATE
Filing Requirement of Act 74, Mich. P.A. 1970

FILED

For corners in

Livingston
(County)

Located In:

Corner Code #

- 1. Public Land Survey T3N R 4E M-2
 T R
 T R
 T R
- 2. Property Controlling S T R
 in Section S T R
- 3. Miscellaneous S T R
 Property in Sec. S T R

1997 JUN 10 A 9: 21
 NANCY HAVILAND
 REGISTER OF DEEDS
 LIVINGSTON COUNTY, MI.
 48843
 L.S.C.#668m
 Register of Deeds Stamp & File Number

- 4. Lot No. _____, Recorded Plat _____
- 5. Private Claims _____

A	B	C	D	E	F	G	H	I	J	K	L	M
1												
2	6		5		4		3		2		1	
3												
4	7		8		9		10		11		12	
5												
6	18		17		16		15		14		13	
7												
8	19		20		21		22		23		24	
9												
10	30		29		28		27		26		25	
11												
12	31		32		33		34		35		36	
13												

I, Charles E Garlock, in a field survey on May 21, 1997 do hereby state that under requirements of P.A. 74, Michigan P.A. of 1970, the corner points mentioned in lines 1 and 2 above were in conformance with regulations and rules therefore as required in the current manual of survey instructions of the United States Department of the Interior, Bureau of Land Management or by a decree of a Court of Law and/or that the corner points mentioned in lines 3, 4 and 5 above were in conformance with the rules of the Michigan Board of Land Surveyors or by a Decree of a Court of Law; established, re-established, monumented, recovered, found as expressed below:

NOTE: Not more than 2 corners, all in the same town and range, may be recorded on this certificate.

A. Description of original monument and accessories and/or subsequent restoration:
 GLO survey dated April 15, 1825 by S Sibley and none of the GLO witnesses remain
 GLO witnesses: B0 10-N48W-20 lks
 R0 -S22W-28 lks


Additional data on rear of sheet

B. Description of corner evidence found and/or method applied in restoring or reestablishing corner:
 Found RR spike on c/l of Road at -0.6'

C. Description of monument for corner and accessories established to perpetuate locating the position of the corner:
 M-2: E1/4 COR. SEC. 1 T3N-R4E, HOWELL TWP. LIV. CO. MI, RESET W/1 1/4" X 36" BREAKAWAY I. PIPE WITH REMON BRASS CAP ON TOP AT -0.5'
 S70W-27.46'-SP & TAG S/S 18" HICKORY
 N24W-66.03'-SP & TAG SW/S 3-8" OAKS
 N11W-99.21'-SP & TAG E/S 24" HICKORY
 N69E-30.76'-SP & TAG S/S 12" OAK
 S61E-29.21'-SP & TAG S/S 3-36" OAKS
 NORTH-98.34'-1/4 COR. IN T3N-R5E

Signed by Charles E Garlock
 Surveyor's Michigan License No. 14762

Date MAY 27, 1997

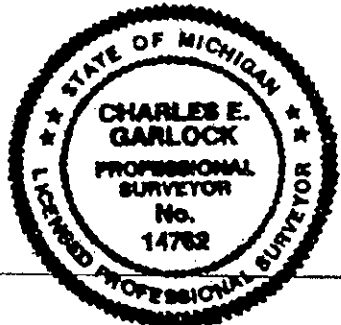

PA. 348 1980, APPROVED BY LIVINGSTON COUNTY
 PEER GROUP ON 2-26-97, CO. REP JED