

MAR 17 2000

SECTION

LAND CORNER RECORDATION CERTIFICATE
Filing Requirement of Act 74, Mich. P.A. 1970

FILED

For corners in

LIVINGSTON Located In: Corner Code #
(County)

1. Public Land Survey T 3N R 5E G-08
T _____ R _____
T _____ R _____
T _____ R _____

2. Property Controlling S _____ T _____ R _____
in Section S _____ T _____ R _____

3. Miscellaneous S _____ T _____ R _____
Property in Sec. S _____ T _____ R _____

4. Lot No. _____, Recorded Plat _____

5. Private Claims _____

1999 NOV 22 A 10: 07

NANCY HAVILAND
REGISTER OF DEEDS
LIVINGSTON COUNTY, MI.
48843

ISC# 1079m
Register of Deeds Stamp & File
Number

I, MARY A. BARNWELL, in a field survey on SEPTEMBER 22, 1999 do hereby state that under requirements of P.A. 74, Michigan P.A. of 1970, the corner points mentioned in lines 1 and 2 above were in conformance with regulations and rules therefore as required in the current manual of survey instructions of the United States Department of the Interior, Bureau of Land Management or by a decree of a Court of Law and /or that the corner points mentioned in lines 3, 4 and 5 above were in conformance with the rules of the Michigan Board of Land Surveyors or by a Decree of a Court of Law; established, re-established, monumented, recovered, found as expressed below:

NOTE: Not more than 2 corners, all in the same town and range, may be recorded on this certificate.

A. Description of original monument and accessories and/or subsequent restoration:

G-08 Oceola Township was set by the GLO in 1823.
The original witnesses are:
White Oak 10" N. 74° W. 22 (14.5')
White Oak 6" N. 39 1/2° E. 4 (2.6')

NOTE: None of the original witnesses could be found or perpetuated.
See the back of this sheet for additional historical data.

B. Description of corner evidence found and/or method applied in restoring or reestablishing corner:


G-08 Found 1/2" Iron 6 feet West of the centerline of Hughes Road (gravel surface running North/South) - tree row East - tree row and rock pile to the West.

C. Description of monument for corner and accessories established to perpetuate locating the position of the corner:

G-08 West 1/4 Corner, Section 22, T3N, R5E - Reset 1/2" Iron with 36" x 1 1/4" Breakaway Iron Pipe W/Brass Cap marked as "Livingston County Monumentation Corner" 6± West of centerline of Gravel Road

N 26° W Set Nail/Remon Washer SW/S 30" Oak 50.31'
N 53° E Set Nail/Remon Washer SE/S 24" Maple 36.28'
S 86° E Set Nail/Remon Washer N/S 12" Twin Elm 43.61'
S 16° E Set Nail/Remon Washer E/S 20" Hickory 82.49'

Signed by Mary A. Barnwell
Surveyor's Michigan License No. 33971

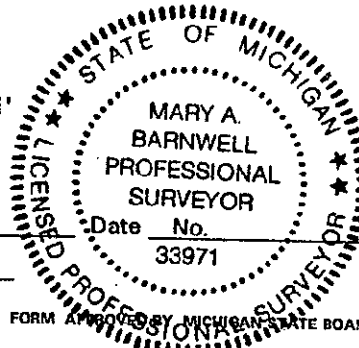

	A	B	C	D	E	F	G	H	I	J	K	L	M
1													
2	6		5		4		3		2				
3													
4	7		8		9		10		11		12		
5													
6	18		17		16		15		14		13		
7													
8	19		20		21		22		23		24		
9													
10	30		29		28		27		26		25		
11													
12	31		32		33		34		35		36		
13													

P.A. 345 1990, APPROVED BY LIVINGSTON COUNTY
PEER GROUP ON 9-15-99 CO. REP JED