

MAR 17 2000

**SECTION LAND CORNER RECORDATION CERTIFICATE**  
 Filing Requirement of Act 74, Mich. P.A. 1970

**FILED**

For corners in

<u>LIVINGSTON</u> (County)	Located In:	Corner Code #
1. Public Land Survey	T <u>3N</u> R <u>5E</u>	<u>G-09</u>
	T _____ R _____	_____
	T _____ R _____	_____
	T _____ R _____	_____
2. Property Controlling In Section	S _____ T _____ R _____	_____
	S _____ T _____ R _____	_____
3. Miscellaneous Property in Sec.	S _____ T _____ R _____	_____
	S _____ T _____ R _____	_____
4. Lot No. _____, Recorded Plat _____		
5. Private Claims _____		

9  
 1999 NOV 22 A 10:07  
 HANCY HAVILAND  
 REGISTER OF DEEDS  
 LIVINGSTON COUNTY, MI.  
 48843  
 LSC# 1080m  
 Register of Deeds Stamp & File  
 Number

I, **MARY A. BARNWELL**, in a field survey on **OCTOBER 22, 1999** do hereby state that under requirements of P.A. 74, Michigan P.A. of 1970, the corner points mentioned in lines 1 and 2 above were in conformance with regulations and rules therefore as required in the current manual of survey instructions of the United States Department of the Interior, Bureau of Land Management or by a decree of a Court of Law and /or that the corner points mentioned in lines 3, 4 and 5 above were in conformance with the rules of the Michigan Board of Land Surveyors or by a Decree of a Court of Law; established, re-established, monumented, recovered, found as expressed below:

A	B	C	D	E	F	G	H	I	J	K	L	M
1												
2	6	5	4	3	2	1						
3												
4	7	8	9	10	11	12						
5												
6	18	17	16	15	14	13						
7												
8	19	20	21	22	23	24						
9												
10	30	29	28	27	26	25						
11												
12	31	32	33	34	35	36						
13												

**NOTE:** Not more than 2 corners, all in the same town and range, may be recorded on this certificate.

A. Description of original monument and accessories and/or subsequent restoration:

G-09 Oceaola Township was set by the GLO in 1823.  
 The original witnesses are:  
 White Oak 20" S. 38° W. 13 (8.6')  
 White Oak 10" N. 01° E. 19 (12.5')

**NOTE:** None of the original witnesses could be found or perpetuated.  
 See the back of this sheet for additional historical data.

B. Description of corner evidence found and/or method applied in restoring or reestablishing corner:


G-09 - Found evidence of a 4"-6" diameter core hole in M-59 pavement 4 feet North of the centerline of M-59. The core hole is approximately 2 feet West of centerline of Hughes Road (gravel surface running North-South).

C. Description of monument for corner and accessories established to perpetuate locating the position of the corner:

G-09 Southwest Corner, Section 22, T3N, R5E - Set 1 1/4" Iron Pipe Stub with Brass Cap marked as "Livingston County Monumentation Corner."

- S 89 1/2° E 10.65' Empty Monument Box in M-59 Pavement
- N 08° E 83.21' Set Nail/Remon Washer W/S 10" Ash
- S 39° E 73.82' Set 1 1/4" Witness Pipe W/Brass Cap Marked as "Livingston County Remonumentation Witness"
- S 50° W 85.71' Set 1 1/4" Witness Pipe W/Brass Cap Marked as "Livingston County Remonumentation Witness"
- N 62° W 126.49' Set Nail/Remon Washer SW/S 8" Walnut
- N 28° W 72.41' Set Nail/Remon Wash NE/S 16" Ash

Signed by \_\_\_\_\_  
 Surveyor's Michigan License No. 33971

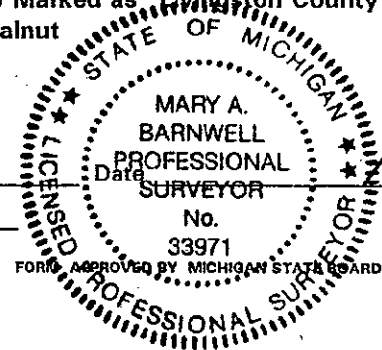

PA. 345 1990, APPROVED BY LIVINGSTON COUNTY  
 PEER GROUP ON 10-8-99 CO. REP JEO