

LAND CORNER RECORDATION CERTIFICATE
Filing Requirement of Act 74, Mich. P.A. 1970

For corners in
LIVINGSTON
(County)

Located In: Corner Code: G-11

- 1. Public Land Survey T 3N R 5E _____
- T _____ R _____
- T _____ R _____
- T _____ R _____
- 2. Property Controlling S _____ T _____ R _____
- in Section S _____ T _____ R _____
- 3. Miscellaneous S _____ T _____ R _____
- Property in Sec. S _____ T _____ R _____

- 4. Lot No. _____, Recorded Plat _____
- 5. Private Claims _____

FILED
 MARGIE HAVILL
 REGISTER OF DEEDS
 LIVINGSTON COUNTY
 48847
 Oct 7 11 09 AM '96

L.S.C.#556M
Register of Deeds Stamp & File Number

	A	B	C	D	E	F	G	H	I	J	K	L	M
2	6	5	4	3	2	1							
3													
4	7	8	9	10	11	12							
5													
6	18	17	16	15	14	13							
7													
8	19	20	21	22	23	24							
9													
10	30	29	28	27	26	25							
11													
12	31	32	33	34	35	36							
13													

I, Jack K. Smith, in a field survey on June 20, 19 96, do hereby certify that under requirements of P.A. 74, Michigan P.A. of 1970, the corner points mentioned in lines 1 and 2 above were in conformance with regulations and rules therefore as required in the current manual of survey instructions of the United States Department of the Interior, Bureau of Land Management or by a decree of a Court of Law and/or that the corner points mentioned in lines 3, 4 and 5 above were in conformance with the rules of the Michigan Board of Land Surveyors or by a Decree of a Court of Law; established, re-established, monumented, re-monumented, recovered, found as expressed below:

NOTE: Not more than 4 corners, all in the same town and range, may be recorded on this certificate.


A. Description of original monument and accessories and/or subsequent restoration:

G-11 The Northwest Corner of Section 34 Oceola Township was set by the GLO in 1823 by Sylvester Sibley.
 The original witnesses are:
 W Oak 14" N66°W 75 lks (49.5')
 W Oak 13" S09°W 51 lks (33.7')

NOTE: NONE OF THE ORIGINAL WITNESSES COULD BE FOUND OR PERPETUATED SEE THE BACK OF THIS SHEET FOR ADDITIONAL HISTORICAL DATA.

B. Description of corner evidence found and/or method applied in restoring or reestablishing corner:

G-11 Found 1/2" Iron Rod in the centerline of Hughes Road with an old fenceline running to the West.

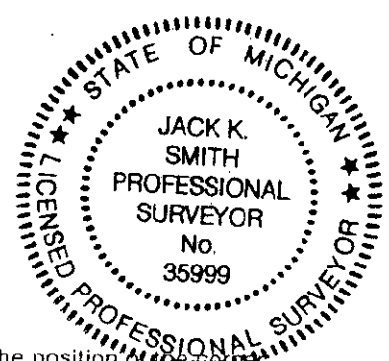

C. Description of monument for corner and accessories established to perpetuate locating the position of the corner:

G-11 Northwest Corner, Section 34, T3N, R5E
 Set 30" x 1 1/4" iron pipe with 6" x 1 1/4" break-off and brass cap marked as "Livingston County Monumentation Corner" in centerline of Hughes Road.

- N88°W Set nail and remon tag in N side 30" Oak 29.29'
- N40°W Set nail and remon tag in NE side 16" Oak 27.69'
- N20°E Set nail and remon tag in NW side 18" Oak 48.68'
- N70°E Set nail and remon tag in SE side 18" Oak 22.45'


Signed by Jack K. Smith
 Surveyor's Michigan License No. 35999

Date June 20, 1996

June 6, 1996

G-11 T3N - R5E: Northwest Corner, Section 34, Oceola Township

We found a 1/2" iron rod in the centerline of Hughes Road. There is an old fenceline running to the west. This corner was reported as being set by Sibley in 1823 for the GLO. There is an Act 74 filed by Boss from 1972 and the witnesses still check well. The Boss measure of 1972 to the east and south are each short by 2-3 feet compared to current measure. We matched the Garlock measure to the South within 2 tenths. Bullock shows a measure from the late 1800's which agrees well with the distance from this corner to the North 1/4 Corner of Section 34. We were unable to determine the origin of the iron that currently marks the corner but could not justify any other position based on the available evidence, therefor I recommend acceptance of the current position as marked by the iron to be replaced with a standard Remonumentation corner. A sweep of the area near this location did not reveal any other corner markers. This corner is heavily masked for GPS in all directions and would make a difficult location for direct occupation with GPS equipment.


Jack K. Smith, PS
Desine Inc.

