

**LAND CORNER RECORDATION CERTIFICATE**  
**Filing Requirement of Act 74, Mich. P.A. 1970**

For corners in

LIVINGSTON  
(County)

Located In:

Corner Code *//*

- |                                    |   |           |   |           |             |
|------------------------------------|---|-----------|---|-----------|-------------|
| 1. Public Land Survey              | T | <u>3N</u> | R | <u>5E</u> | <u>G-12</u> |
|                                    | T | ---       | R | ---       | ---         |
|                                    | T | ---       | R | ---       | ---         |
|                                    | T | ---       | R | ---       | ---         |
| 2. Property Controlling in Section | S | ---       | T | ---       | ---         |
|                                    | S | ---       | T | ---       | ---         |
| 3. Miscellaneous Property in Sec.  | S | ---       | T | ---       | ---         |
|                                    | S | ---       | T | ---       | ---         |

4. Lot No. \_\_\_\_\_, Recorded Plat \_\_\_\_\_  
 5. Private Claims \_\_\_\_\_

FILED  
 Oct 7 11 09 AM '96  
 NANCY HAVILAN,  
 REGISTER OF DEEDS  
 LIVINGSTON COUNTY, MI  
 48843

L.S.C.#557M  
 Register of Deeds Stamp & File Number

A	B	C	D	E	F	G	H	I	J	K	L	M
2	6	5	4	3	2	1						
3												
4	7	8	9	10	11	12						
5												
6	18	17	16	15	14	13						
7												
8	19	20	21	22	23	24						
9												
10	30	29	28	27	26	25						
11												
12	31	32	33	34	35	36						
13												

I, Jack K. Smith, in a field survey on June 20, 1996, do hereby certify that under requirements of P.A. 74, Michigan P.A. of 1970, the corner points mentioned in lines 1 and 2 above were in conformance with regulations and rules therefore as required in the current manual of survey instructions of the United States Department of the Interior, Bureau of Land Management or by a decree of a Court of Law and/or that the corner points mentioned in lines 3, 4 and 5 above were in conformance with the rules of the Michigan Board of Land Surveyors or by a Decree of a Court of Law; established, re-established, monumented, re-monumented, recovered, found as expressed below:

**NOTE: Not more than 4 corners, all in the same town and range, may be recorded on this certificate.**


A. Description of original monument and accessories and/or subsequent restoration:

G-12 The West 1/4 Corner of Section 34 Oceola Township was set by the GLO in 1823 by Sylvester Sibley.  
 The original witnesses are:  
     W Oak 10"      S29 1/2°E      59 lks (38.9')  
     W Oak 9"      N23 1/2°W      62 lks (40.9')

**NOTE: NONE OF THE ORIGINAL WITNESSES COULD BE FOUND OR PERPETUATED SEE THE BACK OF THIS SHEET FOR ADDITIONAL HISTORICAL DATA.**

B. Description of corner evidence found and/or method applied in restoring or reestablishing corner:

G-12 Found 1/2" Iron Rod 5 feet East of the centerline of Hughes Road with old fencelines running to the East and to the West.

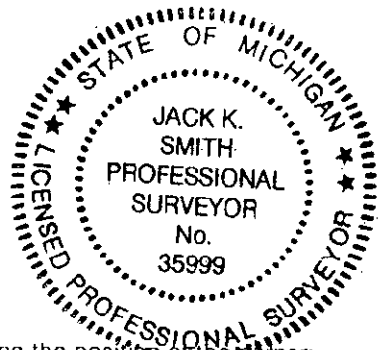

C. Description of monument for corner and accessories established to perpetuate locating the position of the corner:

G-12 West 1/4 Corner, Section 34, T3N, R5E  
 Set 30" x 1 1/4" iron pipe with 6" x 1 1/4" break-off and brass cap marked as "Livingston County Monumentation Corner" 5 feet East of Hughes Road centerline.


- |       |   |        |
|-------|---|--------|
| S85°E | Set nail and remon tag in SW side 36" Maple | 20.77' |
| S20°E | Set nail and remon tag in W side 30" Maple  | 47.15' |
| S30°W | Set nail and remon tag in E side 14" Maple  | 78.19' |
| S85°W | Set nail and remon tag in N side 18" Oak    | 30.46' |

Signed by [Signature] Date June 20, 1996  
 Surveyor's Michigan License No. 35999

June 6, 1996

G-12 T3N - R5E: West 1/4 Corner, Section 34, Oceola Township

We found a 1/2" iron rod 5 feet east of the centerline of Hughes Road. There are old fencelines running to the east and west. This corner was reported as being set by Sibley in 1823 for the GLO. There are Act 74s filed by Boss(1972) and Garlock(1972) and the witnesses still check well. The Boss measure of 1972 to the north is short by 2 feet compared to current measure. We matched the Garlock measure to the north within 2 tenths and distances to the south checked well with Boss, Garlock and Brady. A sweep of the area near this location did not reveal any other corner markers. We were unable to determine the origin of the iron that currently marks the corner but could not justify any other position based on the available evidence, therefore I recommend acceptance of the current position as marked by the iron to be replaced with a standard Remonumentation corner. This corner is heavily masked for GPS in all directions and would make a difficult location for direct occupation with GPS equipment.

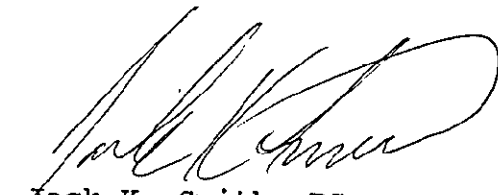  
Jack K. Smith, PS  
Desine Inc.

