

MAR 17 2000

LAND CORNER RECORDATION CERTIFICATE  
Filing Requirement of Act 74, Mich. P.A. 1970

FILED

SECTION

For corners in

<u>LIVINGSTON</u> (County)	Located In:	Corner Code #
1. Public Land Survey	T <u>3N</u> R <u>5E</u>	<u>H-07</u>
	T _____ R _____	_____
	T _____ R _____	_____
	T _____ R _____	_____
2. Property Controlling in Section	S _____ T _____ R _____	_____
	S _____ T _____ R _____	_____
3. Miscellaneous Property in Sec.	S _____ T _____ R _____	_____
	S _____ T _____ R _____	_____
4. Lot No. _____, Recorded Plat _____		
5. Private Claims _____		

9  
1999 NOV 22 A 10:07  
NANCY HAVILAND  
REGISTER OF DEEDS  
LIVINGSTON COUNTY, MI.  
48843  
ISC# 1082m  
Register of Deeds Stamp & File  
Number

I, MARY A. BARNWELL, in a field survey on SEPTEMBER 22, 1999 do hereby state that under requirements of P.A. 74, Michigan P.A. of 1970, the corner points mentioned in lines 1 and 2 above were in conformance with regulations and rules therefore as required in the current manual of survey instructions of the United States Department of the Interior, Bureau of Land Management or by a decree of a Court of Law and /or that the corner points mentioned in lines 3, 4 and 5 above were in conformance with the rules of the Michigan Board of Land Surveyors or by a Decree of a Court of Law; established, re-established, monumented, recovered, found as expressed below:

A	B	C	D	E	F	G	H	I	J	K	L	M
1												
2	6	5	4	3	2	1						
3												
4	7	8	9	10	11	12						
5												
6	18	17	16	15	14	13						
7												
8	19	20	21	22	23	24						
9												
10	30	29	28	27	26	25						
11												
12	31	32	33	34	35	36						
13												

NOTE: Not more than 2 corners, all in the same town and range, may be recorded on this certificate.

A. Description of original monument and accessories and/or subsequent restoration:

H-07 Oceola Township was set by the GLO in 1823.  
The original witnesses are:  
Elm 16" S 50° W 58 (38.3')  
Elm 6" S 34° E 38 (25.1')

NOTE: None of the original witnesses could be found or perpetuated.  
See the back of this sheet for additional historical data.


B. Description of corner evidence found and/or method applied in restoring or reestablishing corner:

H-07 Found 1/2" Iron at the intersection of fence remains running North/South and West  
In wooded area

C. Description of monument for corner and accessories established to perpetuate locating the position of the corner:

H-07 North 1/4 Corner, Section 22, T3N, R5E - Reset 1/2" Iron with 36" x 1 1/4" Iron Pipe with Brass Cap marked as "Livingston County Monumentation Corner" Fence remains N-S-W Fence Post (Rotten) 0.5' West  
N 72° W Set Nail/Remon Washer N/S 20" Maple 38.23'  
S 72° W Set Nail/Remon Washer W/S 12" Maple 11.70'  
S 72° W Set Nail/Remon Washer NW/S 18" Ash 20.41'  
W 72° Set Nail/Remon Washer S/S 26" Ash 40.86'  
No. 1 Carsonite Post 0.5'

Signed by Mary A. Barnwell  
Surveyor's Michigan License No. 33971

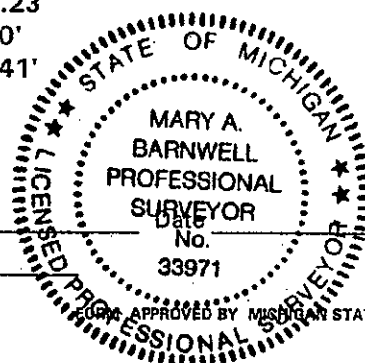

P.A. 345 1990, APPROVED BY LIVINGSTON COUNTY