

MAR 17 2000

FILED

SECTION

LAND CORNER RECORDATION CERTIFICATE
Filing Requirement of Act 74, Mich. P.A. 1970

For corners in

LIVINGSTON Located In: Corner Code #
(County)

1. Public Land Survey T 3N R 5E H-09
T _____ R _____
T _____ R _____
T _____ R _____

2. Property Controlling S _____ T _____ R _____
in Section S _____ T _____ R _____

3. Miscellaneous S _____ T _____ R _____
Property in Sec. S _____ T _____ R _____

1999 NOV 22 A 10:07

NANCY HAVILAND
REGISTER OF DEEDS
LIVINGSTON COUNTY, MI.
48843

JSC# 1083m

Register of Deeds Stamp & File
Number

4. Lot No. _____, Recorded Plat _____
5. Private Claims _____

I, MARY A. BARNWELL, in a field survey on OCTOBER 22, 1999 do hereby state that under requirements of P.A. 74, Michigan P.A. of 1970, the corner points mentioned in lines 1 and 2 above were in conformance with regulations and rules therefore as required in the current manual of survey instructions of the United States Department of the Interior, Bureau of Land Management or by a decree of a Court of Law and /or that the corner points mentioned in lines 3, 4 and 5 above were in conformance with the rules of the Michigan Board of Land Surveyors or by a Decree of a Court of Law; established, re-established, monumented, recovered, found as expressed below:

NOTE: Not more than 2 corners, all in the same town and range, may be recorded on this certificate.

A. Description of original monument and accessories and/or subsequent restoration:

H-09 Oceola Township was set by the GLO in 1823.

The original witnesses are:

- White Oak 30" N. 35 1/2° E. 70 (46.2')
- White Oak 14" S. 38 1/2° W. 16 (10.6')

NOTE: None of the original witnesses could be found or perpetuated.
See the back of this sheet for additional historical data.

B. Description of corner evidence found and/or method applied in restoring or reestablishing corner:


H-09 Found 1 1/2" Iron Bar in Monument Box 3 feet South of the centerline of M-59 in line with an old fence line and tree row to the North. Open field to the South.

C. Description of monument for corner and accessories established to perpetuate locating the position of the corner:

H-09 South 1/4 Corner, Section 22, T3N, R5E - Set Brass Cap marked as "Livingston County Monumentation Corner" on existing 1 1/2" Iron Bar in Monument Box

- N 33° W 42.18' Set Nail W/Remon Washer SW/S 26" Maple
- N 68° W 156.53' Set Nail W/Remon Washer SW/S 14" Oak
- S 45° W 88.57' Set Nail W/Remon Washer NW/S 12" Pear
- S 24° E 70.79' Set Nail W/Remon Washer SW/S Utility Pole
- N 28° E 54.79' Set Nail W/Remon Washer SE/S 12" Elm

Signed by _____
Surveyor's Michigan License No. 33971

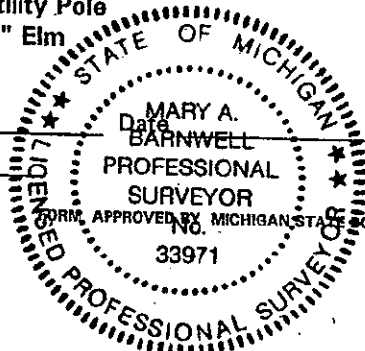

11-4-99

SA. 345 1990, APPROVED BY LIVINGSTON COUNTY

PEER GROUP ON 10.8.99 CO REP JED

	A	B	C	D	E	F	G	H	I	J	K	L
1												
2	6		5		4		3		2		1	
3												
4	7		8		9		10		11		12	
5												
6	18		17		16		15		14		13	
7												
8	19		20		21		22		23		24	
9												
10	30		29		28		27		26		25	
11												
12	31		32		33		34		35		36	
13												