

LAND CORNER RECORDATION CERTIFICATE
Filing Requirement of Act 74, Mich. P.A. 1970

For corners in

LIVINGSTON
(County)

Located In:

Corner Code ##

- 1. Public Land Survey T 3N R 5E H-13
 T _____ R _____
 T _____ R _____
 T _____ R _____
- 2. Property Controlling S _____ T _____ R _____
 in Section S _____ T _____ R _____
- 3. Miscellaneous S _____ T _____ R _____
 Property in Sec. S _____ T _____ R _____

NANCY HAVILLAND
REGISTER OF DEEDS
LIVINGSTON COUNTY, MI
48842

OCT 7 11 09 AM '96

FILED

L.S.C.#560M
Register of Deeds Stamp & File Number

- 4. Lot No. _____, Recorded Plat _____
- 5. Private Claims _____

	A	B	C	D	E	F	G	H	I	J	K	L	M
2	6		5		4		3		2		1		
3													
4	7		8		9		10		11		12		
5													
6	18		17		16		15		14		13		
7													
8	19		20		21		22		23		24		
9													
10	30		29		28		27		26		25		
11													
12	31		32		33		34		35		36		
13													

I, Jack K. Smith, in a field survey on June 20, 1996, do hereby certify that under requirements of P.A. 74, Michigan P.A. of 1970, the corner points mentioned in lines 1 and 2 above were in conformance with regulations and rules therefore as required in the current manual of survey instructions of the United States Department of the Interior, Bureau of Land Management or by a decree of a Court of Law and/or that the corner points mentioned in lines 3, 4 and 5 above were in conformance with the rules of the Michigan Board of Land Surveyors or by a Decree of a Court of Law; established, re-established, monumented, re-monumented, recovered, found as expressed below:

NOTE: Not more than 4 corners, all in the same town and range, may be recorded on this certificate.

A. Description of original monument and accessories and/or subsequent restoration:

H-13 South 1/4 Corner of Section 34 Oceola Township was set by the GLO in 1816 by Alex Holmes.
The original witnesses are:
Ash 15" N26°W 9 lks (5.9')
Elm 12" S30°E 16 lks (10.6')

NOTE: NONE OF THE ORIGINAL WITNESSES COULD BE FOUND OR PERPETUATED
SEE THE BACK OF THIS SHEET FOR ADDITIONAL HISTORICAL DATA.

B. Description of corner evidence found and/or method applied in restoring or reestablishing corner:

H-13 Found 1/2" iron in Golf Club Road with fence and possible tree row to the north.



C. Description of monument for corner and accessories established to perpetuate locating the position of the corner.

H-13 South 1/4 Corner, Section 34, T3N, R5E
Set 30" x 1 1/4" iron pipe with 6" x 1 1/4" break-off and brass cap marked as "Livingston County Monumentation Corner" 2 feet north of road centerline.

- N45°E Set nail and remon tag in SE side 20" Oak 20.50'
- S75°E Set nail and remon tag in N side twin 8" Ash 79.83'
- S75°W Set nail and remon tag in N side 12" Ash 97.19'
- N45°W Set nail and remon tag in SW side 10" Ash 23.43'


Signed by [Signature]
Surveyor's Michigan License No. 35999

Date June 20, 1996

June 6, 1996

H-13 T3N - R5E: South 1/4 Corner, Section 34, Oceola Township

We found a 1/2" iron in Golf Club Road. There is fence and a possible tree row to the north starting north of the roadside drainage ditch, and occupation to the south at the closing corner. This corner was reported as being set by Holmes in 1816 for the GLO. There are Act 74s filed by Wilson(1972), Boss(1972) and Defenderfer(1993) and the witnesses still check well. The closing corner for Genoa falls 97.02 feet west of H-13. All measures since 1975 compare well with current distances. A sweep of the area near this location did not reveal any other corner markers. The current position seems to be a perpetuation of the location witnessed by Wilson in 1972. Considering the perpetuation of this corner since 1972 and the universal acceptance of this position by local surveyors I recommend acceptance of the current location to be replaced by a standard Livingston County Remonumentation monument. This corner is masked for GPS occupation in the summer by trees but may be occupiable with careful pre-planning.

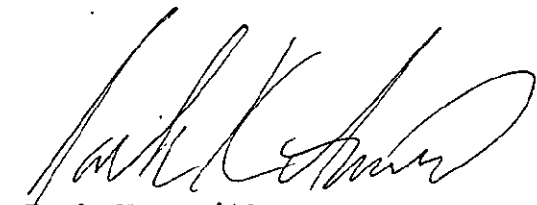

Jack K. Smith, PS
Desine Inc.

