## LAND CORNER RECORDATION CERTIFICATE Filing Requirement of Act 74, Mich. P.A. 1970

For corners in			- 0 1
LIVINGSTON	Located In:	Corner Code :##	1 00 CT
Public Land Survey	у т ЗN_ R 5E	I-13	7   VANCY CISTED
	T R T R		HAVILLED BROFD
Property Controlling     in Section	g .S T R :S T R		L.S.C.#563w
3. Miscellaneous Property in Sec.	S T R S T R		L.S.C.#563M
4. Lot No	, Recorded Plat		
5. Private Claims			2 6 5 4 3 2
*			3 9 10 13 12

do hereby certify that under requirements of P.A. 74, Michigan P.A. of 1970, the corner points mentioned in lines 1 and 2 above were in conformance with regulations and rules therefore as required in the current manual of survey instructions of the United States Department of the Interior, Bureau of Land Management or by a decree of a Court of Law and/or that the corner points mentioned in lines 3.4 and 5 above were in conformance with the rules of the Michigan Board of Land Surveyors or by a Decree of a Court of Law; established, re-established, monumented, re-monumented, recovered, found as expressed below:

NOTE: Not more than 4 corners, all in the same town and range, may be recorded on this certificate.


- A. Description of original monument and accessories and/or subsequent restoration:
  - I-13 Southeast Corner of Section 34 Oceola Township was set by the GLO in 1816 by Alex Holmes, D.S. The original witnesses are:

Tamarack 8" N60°E 28 lks (18.5')

Tamarack 8" S23°E 35 lks (23.1')

NOTE: NONE OF THE ORIGINAL WITNESSES COULD BE FOUND OR PERPETUATED SEE THE BACK OF THIS SHEET FOR ADDITIONAL HISTORICAL DATA.

- B. Description of corner evidence found and/or method applied in restoring or reestablishing corner:
  - I-13 Found 1/2" iron at the intersection of the centerlines of Argentine and Golf Club Roads.

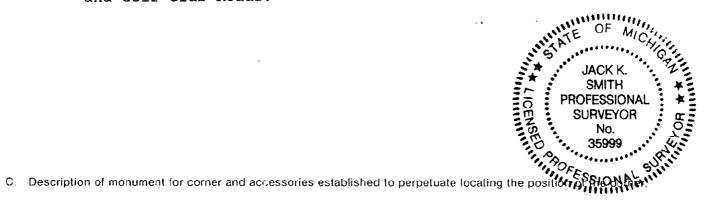

I-13 Southeast Corner, Section 34, T3N, R5E

Set 30" x 1 1/4" iron pipe with 6" x 1 1/4" break-off and brass cap marked

as "Livingston County Monumentation Corner" at intersection of road centerlines.

N15°W Set nail and remon tag in E side 36" Maple 81.63' S75°W Set nail and remon tag in N side 30" Maple 72.32' S10°W Set nail and remon tag in NW side 14" Ash 30.58' S10°E Set nail and remon tag in SW side 8" Ash 32.17'

Signed by Dale June 20, 1996

Surveyor's Michigan License No. 35999 .....

FORM APPROVED BY MICHIGAN STATE BOARD OF LAND SURVEYORS, JAN. 28, 1971

REVISED JAN . 1983

## Southeast Corner, Section 34, Oceola Township I-13 T3N - R5E:

We found a 1/2" iron at the intersection of centerlines of Golf Club and Argentine Roads. This corner was reported as being set by Holmes in 1816 for the GLO. There are two Act 74s filed by Boss(1972). The closing corner for Genoa falls 107.90 feet west of I-13. GLO distance is 1.63 chains(107.6 feet) so it would appear that one of these corners was set at the falling distance on line. All measures since 1975 compare well with current distances. A sweep of the area near this location did not reveal any other corner markers. Considering the perpetuation of this corner since 1972 and the widespread acceptance of this corner by local surveyors I recommend acceptance of the current location with the replacement of the existing iron with a standard Livingston County Remonumentation monument. This corner is heavily masked for GPS occupation by trees and is probably not occupiable with GPS equipment.

Desine Inc.

OF MICKING SMITH PROFESSIONAL SURVEYOR No.