

MAR 17 2000

SECTION

LAND CORNER RECORDATION CERTIFICATE  
Filing Requirement of Act 74, Mich. P.A. 1970

FILED

For corners in

<u>LIVINGSTON</u> (County)	Located In:	Corner Code #
1. Public Land Survey	T <u>3N</u> R <u>5E</u>	<u>J-09</u>
	T _____ R _____	_____
	T _____ R _____	_____
	T _____ R _____	_____
2. Property Controlling in Section	S _____ T _____ R _____	_____
	S _____ T _____ R _____	_____
3. Miscellaneous Property in Sec.	S _____ T _____ R _____	_____
	S _____ T _____ R _____	_____
4. Lot No. _____, Recorded Plat _____		
5. Private Claims _____		

9  
1999 NOV 22 A 10:08  
NANCY HAVILAND  
REGISTER OF DEEDS  
LIVINGSTON COUNTY, MI.  
48843  
J.S.C# 1087m  
Register of Deeds Stamp & File  
Number

I, MARY A. BARNWELL, in a field survey on OCTOBER 22, 1999 do hereby state that under requirements of P.A. 74, Michigan P.A. of 1970, the corner points mentioned in lines 1 and 2 above were in conformance with regulations and rules therefore as required in the current manual of survey instructions of the United States Department of the Interior, Bureau of Land Management or by a decree of a Court of Law and /or that the corner points mentioned in lines 3, 4 and 5 above were in conformance with the rules of the Michigan Board of Land Surveyors or by a Decree of a Court of Law; established, re-established, monumented, recovered, found as expressed below:

	A	B	C	D	E	F	G	H	I	J	K	L	M
2	6	5	4	3	2	1							
3													
4	7	8	9	10	11	12							
5													
6	18	17	16	15	14	13							
7													
8	19	20	21	22	23	24							
9													
10	30	29	28	27	26	25							
11													
12	31	32	33	34	35	36							
13													

NOTE: Not more than 2 corners, all in the same town and range, may be recorded on this certificate.

A. Description of original monument and accessories and/or subsequent restoration:

J-09 Oceola Township was set by the GLO in 1823.  
The original witnesses are:  
White Oak 36" N. 80° E. 38 (25.1')  
B. Oak 14" N. 56° W. 32 (21.1')

NOTE: None of the original witnesses could be found or perpetuated.  
See the back of this sheet for additional historical data.

B. Description of corner evidence found and/or method applied in restoring or reestablishing corner:


J-09 Found 3/4" Iron Bar in Monument Box 4 feet North of pavement centerline M-59 and in line with centerline of Botsford Road (gravel surface running North) - in line with tree line running South.

C. Description of monument for corner and accessories established to perpetuate locating the position of the corner:

J-09 North 1/4 Corner, Section 26, T3N, R5E - Set Brass Cap marked as "Livingston County Monumentation Corner" on existing 3/4" Iron Bar in Monument Box.

- N 15° W 73.11' Set Nail/Remon Washer E/S 24" Walnut
- N 53° W 85.46' Set Nail/Remon Washer NE/S 12" Walnut
- S 01° E 120.04' Set Nail/Remon Washer E/S 24" Hickory
- S 32° E 76.21' NW Corner Concrete Base Stone Church Sign
- N 20° E 70.98' Set Nail/Remon Washer W/S 14" Elm

Signed by \_\_\_\_\_  
Surveyor's Michigan License No. 33971

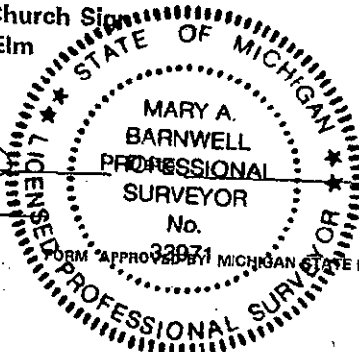

11-4-99

PA. 345 1990, APPROVED BY LIVINGSTON COUNTY  
PEER GROUP ON 10.8.99 CO. REP JED