

LAND CORNER RECORDATION CERTIFICATE
Filing Requirement of Act 74, Mich. P.A. 1970

For corners in

LIVINGSTON
(County)

Located In:

Corner Code: #


- 1. Public Land Survey T 3N R 5E J-13
- T _____ R _____
- T _____ R _____
- T _____ R _____
- 2. Property Controlling S _____ T _____ R _____
- in Section S _____ T _____ R _____
- 3. Miscellaneous S _____ T _____ R _____
- Property in Sec. S _____ T _____ R _____

- 4. Lot No. _____, Recorded Plat _____
- 5. Private Claims _____

NANCY HAVILLAN,
REGISTER OF DEEDS,
LIVINGSTON COUNTY, MI
48843
OCT 7 11 11 AM '96

FILED

L. S. C. #565M
Register of Deeds Stamp & File Number

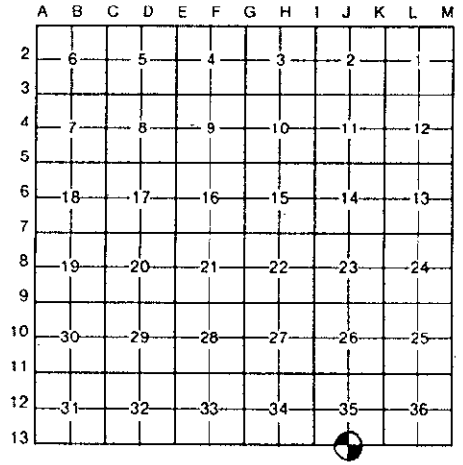

I, Jack K. Smith, in a field survey on June 20, 19 96
do hereby certify that under requirements of P.A. 74, Michigan P.A. of 1970, the corner points mentioned
in lines 1 and 2 above were in conformance with regulations and rules therefore as required in the
current manual of survey instructions of the United States Department of the Interior, Bureau of Land
Management or by a decree of a Court of Law and/or that the corner points mentioned in lines 3, 4 and 5
above were in conformance with the rules of the Michigan Board of Land Surveyors or by a Decree of a
Court of Law; established, re-established, monumented, re-monumented, recovered, found as
expressed below:

NOTE: Not more than 4 corners, all in the same town and range, may be recorded
on this certificate.

A. Description of original monument and accessories and/or subsequent restoration:

J-13 South 1/4 Corner of Section 35 Oceola Township was set by the
GLO in 1816 by Alex Holmes, D.S.
The original witnesses are:
Aspen 12" S47°E 16 lks (10.6')
W Oak 18" N53°E 45 lks (29.7')

NOTE: NONE OF THE ORIGINAL WITNESSES COULD BE FOUND OR PERPETUATED
SEE THE BACK OF THIS SHEET FOR ADDITIONAL HISTORICAL DATA.

B. Description of corner evidence found and/or method applied in restoring or reestablishing corner:

J-13 Found railroad spike 2.5 feet North of Golf Club Road centerline with
an old fence line and tree row running North.



C. Description of monument for corner and accessories established to perpetuate locating the position of the corner:

J-13 South 1/4 Corner, Section 35, T3N, R5E
Set 30" x 1 1/4" iron pipe with 6" x 1 1/4" break-off and brass cap marked
as "Livingston County Monumentation Corner" 2.5 feet North of Golf Club Road
centerline.


- N55°E Set nail and remon tag in NW side 16" Ash 31.88'
- N45°W Set nail and remon tag in SW side 14" Ash 25.06'
- SOUTH Set nail and remon tag in E side 10" Ash 33.62'
- S45°W Set nail and remon tag in SE side 10" Ash 47.13'

Signed by [Signature] Date June 20, 1996
Surveyor's Michigan License No. 35999

June 6, 1996

J-13 T3N - R5E: South 1/4 Corner, Section 35, Oceola Township

We found a Railroad spike in the centerline of Golf Club Road. There is an old fence line and tree row to the north. This corner was reported as being set by Holmes in 1816 for the GLO. There are no Act 74s filed for this corner. The closing corner for Genoa falls 70.10 feet west of J-13. There is not much recorded survey history associated with this corner. A sweep of the area near this location did not reveal any other corner markers. The current position seems to be set by occupational evidence. I could not determine the origin of the present iron. Given the fact that the current location is not disputed by contrary evidence and that occupation agrees with the corner marker I recommend acceptance of the current location to be replaced by a standard Livingston County Remonumentation monument. This corner is masked for GPS occupation in the summer by trees to the north and south but may be occupiable with careful pre-planning.

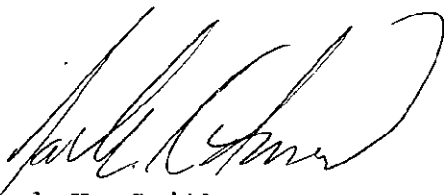

Jack K. Smith, PS
Desine Inc.

