

1993

COMMISSION

LAND CORNER RECORDATION CERTIFICATE  
Filing Requirement of Act 74, Mich. P.A. 1970

Dec 28 4 35 PM '93  
NANCY HAVILAND  
REGISTER OF DEEDS  
LIVINGSTON COUNTY, MI  
48043

FILED

For corners in

<u>LIVINGSTON</u> <small>(County)</small>	Located In:	Corner Code #
1. Public Land Survey	T <u>3N</u> R <u>5E</u>	<u>K-12</u>
	T _____ R _____	_____
	T _____ R _____	_____
	T _____ R _____	_____
2. Property Controlling in Section	S _____ T _____ R _____	_____
	S _____ T _____ R _____	_____
3. Miscellaneous Property in Sec.	S _____ T _____ R _____	_____
	S _____ T _____ R _____	_____

L.S.C. #158m  
Register of Deeds Stamp & File Number

4. Lot No. \_\_\_\_\_, Recorded Plat \_\_\_\_\_  
5. Private Claims \_\_\_\_\_

	A	B	C	D	E	F	G	H	I	J	K	L	M
2	6		5		4		3		2		1		
3													
4	7		8		9		10		11		12		
5													
6	18		17		16		15		14		13		
7													
8	19		20		21		22		23		24		
9													
10	30		29		28		27		26		25		
11													
12	31		32		33		34		35		36		
13													

MARY A. BARNWELL  
I, \_\_\_\_\_, in a field survey on DECEMBER 06, 19 93

do hereby certify that under requirements of P.A. 74, Michigan P.A. of 1970, the corner points mentioned in lines 1 and 2 above were in conformance with regulations and rules therefore as required in the current manual of survey instructions of the United States Department of the Interior, Bureau of Land Management or by a decree of a Court of Law and/or that the corner points mentioned in lines 3, 4 and 5 above were in conformance with the rules of the Michigan Board of Land Surveyors or by a Decree of a Court of Law; established, re-established, monumented, re-monumented, recovered, found as expressed below:

NOTE: Not more than 4 corners, all in the same town and range, may be recorded on this certificate.

A. Description of original monument and accessories and/or subsequent restoration:

K-12 The West 1/4 Corner of Section 36, Oceola Township was set by the GLO in 1815 by Joseph Wampler.  
The original witnesses are:  
W. Oak 12" S86 1/2E 12 lks  
Hickory 8" S4E 12 lks

NOTE: NONE OF THE ORIGINAL WITNESSES COULD BE FOUND OR PERPETUATED  
SEE THE BACK OF THIS SHEET FOR ADDITIONAL HISTORICAL DATA.

B. Description of corner evidence found and/or method applied in restoring or reestablishing corner:

K-12 Found 3/8" iron rod. All known surveys since 1974 by Boss, Benton, Garlock, and Desine appear to be tied to this same corner location.


NOTE : SEE THE DOSSIER AS FILED FOR THE LIVINGSTON COUNTY  
REMONUMENTATION PROGRAM FOR ADDITIONAL INFORMATION  
CONCERNING THIS CORNER.

C. Description of monument for corner and accessories established to perpetuate locating the position of the corner:

West 1/4 Corner, Section 36, T3N, R5E  
Set 30" x 1 1/4" iron pipe with 6" break-off pipe and brass cap marked as "Livingston County Monument Corner"  
S50°W Nail and tag in SE side 12" Hickory 37.71'  
N82°W Nail and tag in N side Tw. 12" Ash 35.30'  
N80°E Nail and tag in N side 18" Oak 26.53'  
S38°E Nail and tag in SW side 8" Oak 37.49'

APPROVED BY THE LIVINGSTON COUNTY OF MONUMENTATION PEER GROUP OCT. 13 1993.


Signed by Mary A. Barnwell Date DECEMBER 24, 1993  
Surveyor's Michigan License No. 33971  
FORM APPROVED BY MICHIGAN STATE BOARD OF LAND SURVEYORS, JAN. 28, 1971  
REVISED MAY 14, 1975  
REVISED JAN., 1983

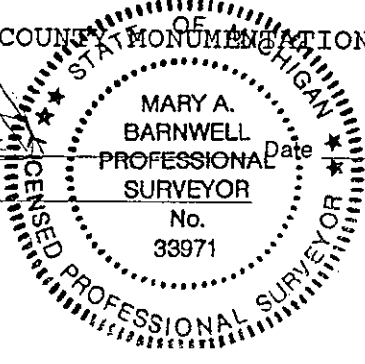

October 13, 1993

**K-12, T3N, R5E: WEST 1/4 CORNER, SECTION 36, OCEOLA TOWNSHIP**

Found 3/8" Iron Rod. 50 inch diam tree 60 ft +/- East. Fence in center of 10 inch diam tree West. All known surveys since 1974 by Boss, Benton, Garlock and Desine appear to be tied to the same corner location. A sweep of the area found no additional irons. Based upon occupational evidence, previous usage and long-standing acceptance, I recommend approving the location of the corner at the point as currently marked.

  
Mary A. Barnwell, PS  
Desine Inc.

