

**LAND CORNER RECORDATION CERTIFICATE**  
 Filing Requirement of Act 74, Mich. P.A. 1970

Or corners in

LIVINGSTON  
 (County)

Located In:

Corner Code #

- Public Land Survey	T	<u>3N</u>	R	<u>5E</u>	<u>M-05</u>
	T		R		
	T		R		
	T		R		
- Property Controlling in Section	S		T		
	S		T		
- Miscellaneous Property in Sec.	S		T		
	S		T		

HANCOCK HAVILAND  
 REGISTER OF DEEDS  
 LIVINGSTON COUNTY, MI  
 48843  
 OCT 17 10 34 AM '95

FILED

L.S.C.#513m

Register of Deeds Stamp & File Number

Lot No. \_\_\_\_\_, Recorded Plat \_\_\_\_\_  
 Private Claims \_\_\_\_\_

	A	B	C	D	E	F	G	H	I	J	K	L	M
2	6	5	4	3	2	1							
3													
4	7	8	9	10	11	12							
5													
6	18	17	16	15	14	13							
7													
8	19	20	21	22	23	24							
9													
10	30	29	28	27	26	25							
11													
12	31	32	33	34	35	36							
13													

Jack K. Smith in a field survey on October 10, 1995  
 I hereby certify that under requirements of P.A. 74, Michigan P.A. of 1970, the corner points mentioned in lines 1 and 2 above were in conformance with regulations and rules therefore as required in the current manual of survey instructions of the United States Department of the Interior, Bureau of Land Management or by a decree of a Court of Law and/or that the corner points mentioned in lines 3, 4 and 5 above were in conformance with the rules of the Michigan Board of Land Surveyors or by a Decree of a Court of Law, established, re-established, monumented, re-monumented, recovered, found as expressed below:

NOTE: Not more than 4 corners, all in the same town and range, may be recorded on this certificate.

A. Description of original monument and accessories and/or subsequent restoration:


M-05 The Northeast Corner of Section 13, Oceola Township was set by the GLO in 1816 by A. Holmes.  
 The original witnesses are:  
 Elm 9" S16°E 13 lks (8.6')  
 Elm 10" N66°W 11 lks (7.3')

NOTE: NONE OF THE ORIGINAL WITNESSES COULD BE FOUND OR PERPETUATED  
 SEE THE BACK OF THIS SHEET FOR ADDITIONAL HISTORICAL DATA.

B. Description of corner evidence found and/or method applied in restoring or reestablishing corner:

M-05 Found 1/2" iron at jog in Dwyer Road.

SURVEY &  
 REMONUMENTATION  
 NOV 27 1995  
 COMMISSION

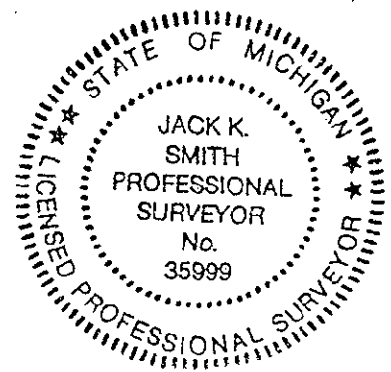

C. Description of monument for corner and accessories established to perpetuate locating the position of the corner:

M-05 Northeast Corner, Section 13, T3N, R5E  
 Set 36" x 1 1/4" iron pipe with brass cap marked as "Livingston County Monument Corner" 18 feet ± SW'ly of SE edge of gravel  
 N58°W Set nail and tag in S side 8" Oak 64.22'  
 N58°E Set nail and tag NW side 12" Elm 20.96'  
 S06°E Set nail and tag in W side 18" Oak 9.28'  
 S02°W Set nail and tag in W side 10" Hickory 23.41'


Signed by [Signature] Date October 10, 1995

Surveyor's Michigan License No. 35999  
 PA 345 1990. APPROVED BY LIVINGSTON COUNTY

April 2, 1994

M-05 T3N - R5E: Northeast Corner, Section 13, Oceola Township

We found a 1/2" iron at the jog in Dwyer Road. The corner was originally recorded as being set by Alex Holmes in 1815 for the GLO. The GLO notes for Hartland Township call for a jog of 212.5 feet, with current measure being 195.2 feet. Current measure to west matches well with Boss, Kapila, Hughes and Desine. The Bullock distance to the west is 5.6 feet longer than present measure. There is a tree with fence running north and west out of it (through it) about 10 feet south and 4 feet to the east of the iron, but there was not sufficient evidence to warrant moving the present location. The iron that is marking this corner was shown on a survey drawing as a set by Kapila and Assoc. in 1979. Witnesses from that drawing still check well with present measure. A sweep of the area near this location did not reveal any other corner markers. This corner is masked to the north and south for GPS but should be occupiable with planning. I recommend accepting M-05, the Northeast Corner of Section 13, Oceola at the location as is presently monumented.

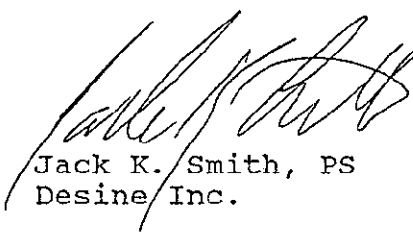  
Jack K. Smith, PS  
Desine Inc.

