

**SURVEY &  
REMONUMENTATION**

DEC 07 1994

**LAND CORNER RECORDATION CERTIFICATE**  
Filing Requirement of Act 74, Mich. P.A. 1970

SEP 15 8 58 AM '94  
NANCY HAVILLAND  
REGISTER OF DEEDS  
LIVINGSTON COUNTY, MI  
48843

FILED

For corners in  
LIVINGSTON **COMMISSION**  
(County)

Located In: Corner Code #

- |                                       |                         |       |
|---------------------------------------|-------------------------|-------|
| 1. Public Land Survey                 | T <u>3N</u> R <u>5E</u> | M-08  |
|                                       | T _____ R _____         | _____ |
|                                       | T _____ R _____         | _____ |
|                                       | T _____ R _____         | _____ |
| 2. Property Controlling<br>in Section | S _____ T _____ R _____ | _____ |
|                                       | S _____ T _____ R _____ | _____ |
| 3. Miscellaneous<br>Property in Sec.  | S _____ T _____ R _____ | _____ |
|                                       | S _____ T _____ R _____ | _____ |

L.S.C.#258m

Register of Deeds Stamp & File Number

4. Lot No. \_\_\_\_\_, Recorded Plat \_\_\_\_\_  
5. Private Claims \_\_\_\_\_

A	B	C	D	E	F	G	H	I	J	K	L	M
2	6	5	4	3	2	1						
3												
4	7	8	9	10	11	12						
5												
6	18	17	16	15	14	13						
7												
8	19	20	21	22	23	24						
9												
10	30	29	28	27	26	25						
11												
12	31	32	33	34	35	36						
13												

I, Jack K. Smith, in a field survey on August 17, 19 94, do hereby certify that under requirements of P.A. 74, Michigan P.A. of 1970, the corner points mentioned in lines 1 and 2 above were in conformance with regulations and rules therefore as required in the current manual of survey instructions of the United States Department of the Interior, Bureau of Land Management or by a decree of a Court of Law and/or that the corner points mentioned in lines 3, 4 and 5 above were in conformance with the rules of the Michigan Board of Land Surveyors or by a Decree of a Court of Law; established, re-established, monumented, re-monumented, recovered, found as expressed below:

**NOTE: Not more than 4 corners, all in the same town and range, may be recorded on this certificate.**

A. Description of original monument and accessories and/or subsequent restoration:

M-08 The East 1/4 Corner of Section 24, Oceola Township was set by the GLO in 1815 by Alex Holmes.  
The original witnesses are:  
W. Oak 18" N59W 23 lks  
B. Oak 14" S73E 28 lks


**NOTE: NONE OF THE ORIGINAL WITNESSES COULD BE FOUND OR PERPETUATED SEE THE BACK OF THIS SHEET FOR ADDITIONAL HISTORICAL DATA.**

B. Description of corner evidence found and/or method applied in restoring or reestablishing corner:

M-08 Found 1/2" iron 3 feet west of the centerline of Hacker Road.  
There is a fairly recent fenceline to the west.

C. Description of monument for corner and accessories established to perpetuate locating the position of the corner:

East 1/4 Corner, Section 24, T3N, R5E  
Set 36" x 1 1/4" iron pipe with brass cap marked as "Livingston County Monument Corner"  
N68°W Nail and tag NE side 20" Oak 19.49'  
N85°E Nail and tag S side twin 8" & 12" Hickory 25.80'  
S24°W Nail and tag in E side 16" Oak 52.78'  
N40°E Nail and tag in W side 20" Oak 30.68'

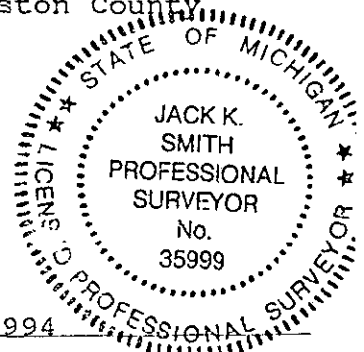

Signed by Jack K. Smith


Date September 8, 1994

Surveyor's Michigan License No. 35999

July 12, 1994

M-08 T3N - R5E: East 1/4 Corner, Section 24, Oceola Township

We found a 1/2" iron 3 feet west of the centerline of Hacker Road (gravel). There is a relatively young fenceline to the west. The GLO calls for a jog of 144.54 feet. The measured distance at the present time is 164.9 (Boss 1979). The corner was originally recorded as being set by Alex Holmes for the GLO in 1815. This corner is shown on old County surveyor notes in 1878 with one witness (now gone). Gary Boss recorded an Act 74 in 1979 in which he states that he set the present corner on the East line of the section at a fenceline to the west. There were no discrepancies found in record measures of this point. A sweep of the area near this iron did not reveal any other corner markers. This corner is in a treed area and is only open for GPS use to the southeast, therefor it would be a difficult point for GPS usage. I recommend accepting M-08, the East 1/4 Corner of Section 24, Oceola at the location as is presently monumented.

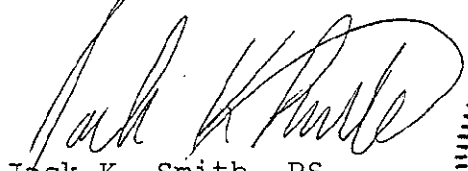  
Jack K. Smith, PS  
Desine Inc.

