

1993

COMMISSION

LAND CORNER RECORDATION CERTIFICATE  
Filing Requirement of Act 74, Mich. P.A. 1970

For corners in

LIVINGSTON  
(County)

Located In:

Corner Code #

- 1. Public Land Survey T 3N R 5E M-13  
T \_\_\_\_\_ R \_\_\_\_\_  
T \_\_\_\_\_ R \_\_\_\_\_  
T \_\_\_\_\_ R \_\_\_\_\_
- 2. Property Controlling S \_\_\_\_\_ T \_\_\_\_\_ R \_\_\_\_\_  
in Section S \_\_\_\_\_ T \_\_\_\_\_ R \_\_\_\_\_
- 3. Miscellaneous S \_\_\_\_\_ T \_\_\_\_\_ R \_\_\_\_\_  
Property in Sec. S \_\_\_\_\_ T \_\_\_\_\_ R \_\_\_\_\_

Dec 28 4 35 PM '93  
NANCY HAVILAND  
REGISTER OF DEEDS  
LIVINGSTON COUNTY, MI  
48843

FILED

L.S.C. #155m  
Register of Deeds Stamp & File Number

- 4. Lot No. \_\_\_\_\_, Recorded Plat \_\_\_\_\_
- 5. Private Claims \_\_\_\_\_

A	B	C	D	E	F	G	H	I	J	K	L	M
2	6	5	4	3	2	1						
3												
4	7	8	9	10	11	12						
5												
6	18	17	16	15	14	13						
7												
8	19	20	21	22	23	24						
9												
10	30	29	28	27	26	25						
11												
12	31	32	33	34	35	36						
13												

MARY A. BARNWELL

I, MARY A. BARNWELL, in a field survey on DECEMBER 06, 19 93, do hereby certify that under requirements of P.A. 74, Michigan P.A. of 1970, the corner points mentioned in lines 1 and 2 above were in conformance with regulations and rules therefore as required in the current manual of survey instructions of the United States Department of the Interior, Bureau of Land Management or by a decree of a Court of Law and/or that the corner points mentioned in lines 3, 4 and 5 above were in conformance with the rules of the Michigan Board of Land Surveyors or by a Decree of a Court of Law; established, re-established, monumented, re-monumented, recovered, found as expressed below:

NOTE: Not more than 4 corners, all in the same town and range, may be recorded on this certificate.

A. Description of original monument and accessories and/or subsequent restoration:

M-13 The Southeast Corner of Section 36, Oceola Township was set by the GLO in 1815 by Joseph Wampler.  
The original witnesses are:  
W. Oak 18" S-E 31 lks  
B. Oak 12" N 1.05 lks

NOTE: NONE OF THE ORIGINAL WITNESSES COULD BE FOUND OR PERPETUATED  
SEE THE BACK OF THIS SHEET FOR ADDITIONAL HISTORICAL DATA.

B. Description of corner evidence found and/or method applied in restoring or reestablishing corner:

M-13 Found Nail in pipe in monument box at centerline intersection of Golf Club Road and Hacker Road to the west.

NOTE :: SEE THE DOSSIER AS FILED FOR THE LIVINGSTON COUNTY  
REMONUMENTATION PROGRAM FOR ADDITIONAL INFORMATION  
CONCERNING THIS CORNER.


C. Description of monument for corner and accessories established to perpetuate locating the position of the corner:

Southeast Corner, Section 36, T3N, R5E  
Set 30" x 1 1/4" iron pipe with 6" break-off pipe and brass cap marked as "Livingston County Monument Corner"  
S56°W Nail and tag in NW side multiple 8" Maple 37.71'  
N20°E Nail and tag in NW side 12" Oak 102.75'  
N78°E Nail and tag in N side Tw. 8" Oak 62.69'  
S78°E Nail and tag in S side Tw. 8 and 12" Apple 60.60'

APPROVED BY THE LIVINGSTON COUNTY OF MONUMENTATION PEER GROUP OCT. 13 1993.

Signed by Mary A. Barnwell

Surveyor's Michigan License No. 33971

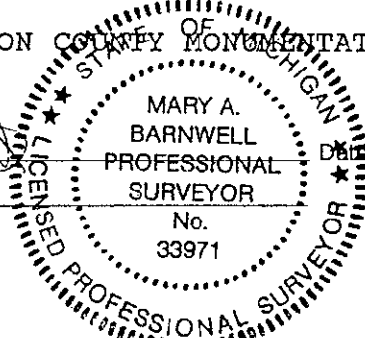


DECEMBER 24, 1993

October 13, 1993

M-13, T3N, R5E: SOUTHEAST CORNER, SECTION 36, OCEOLA TOWNSHIP

Found nail in pipe in monument box at intersection of centerline North - South road with road to West. No occupation to the East. All known surveys since 1943 by Gordon, Garlock, Boss and Desine appear to be tied to the same corner location. All known survey records indicate that this is a common Township corner. A sweep of the area found no additional irons. Based upon occupational evidence, previous usage and long standing acceptance, I recommend approving the location of the corner at the point as currently marked.

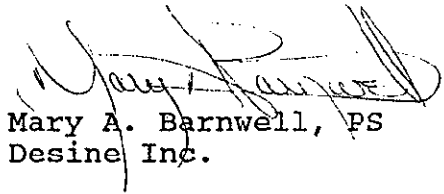  
Mary A. Barnwell, PS  
Desine Inc.

