


HARTLAND TWP.

T3N , R6E

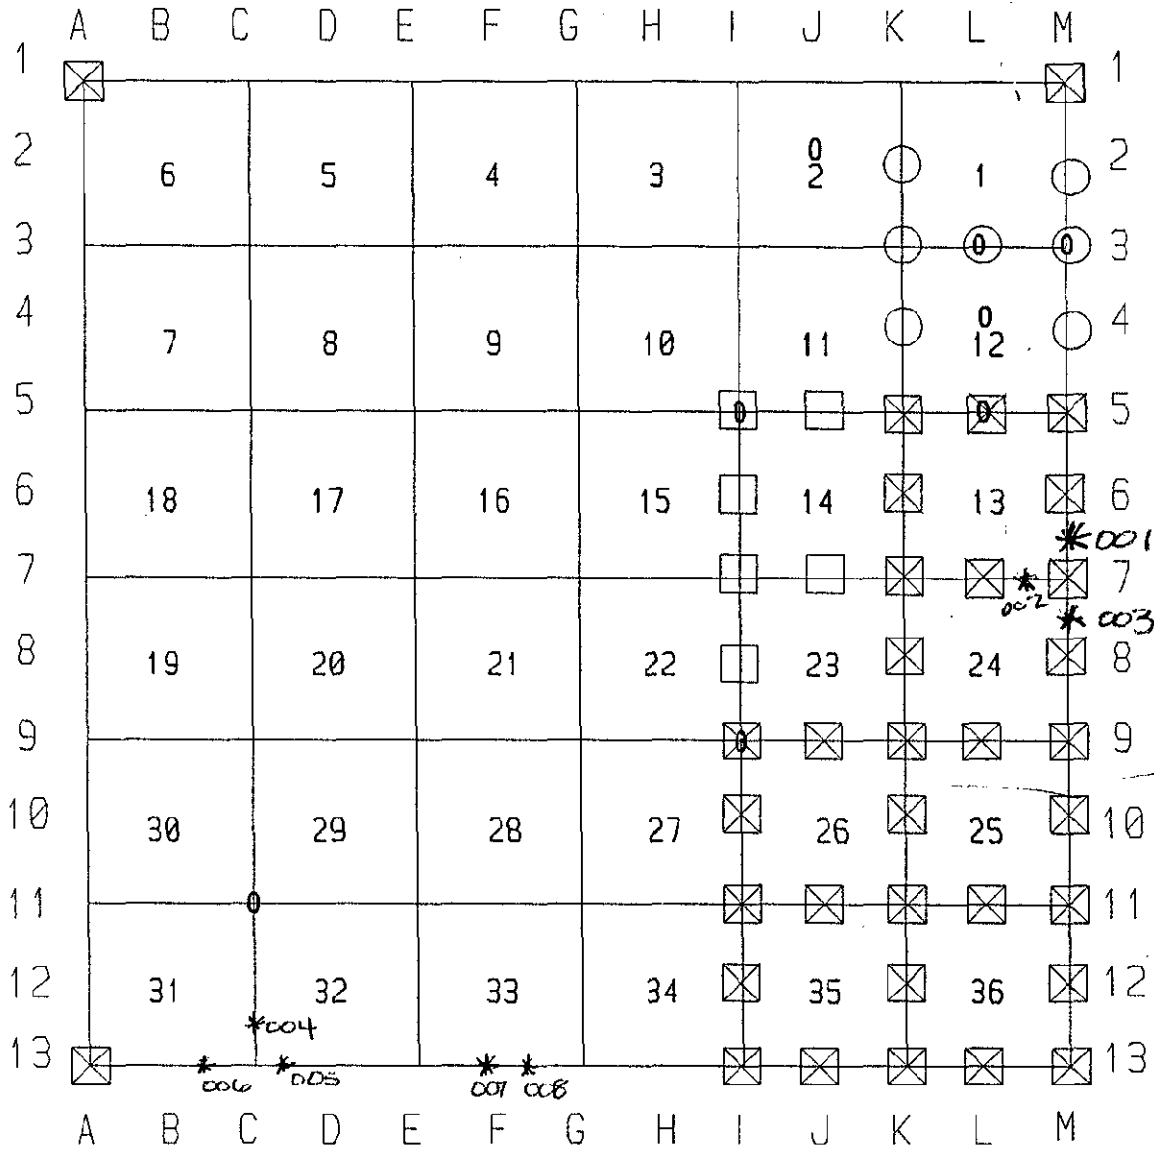

LEGEND

**SURVEY &
REMONUMENTATION**

JUN 01 1998

SECTION

- ☒ CORNERS COMPLETED TO DATE
- 1996 PROPOSED CORNERS
- 1997 PROPOSED CORNERS
- DOUBLE/PROBLEM CORNERS