

MAR 17 2000

SECTION

FILED

LAND CORNER RECORDATION CERTIFICATE 1999 JUL 29 P 12: 27
Filing Requirement of Act 74, Mich. P.A. 1970

For corners in

NANCY HAVILAND
REGISTER OF DEEDS
LIVINGSTON COUNTY, MI.
48843

LIVINGSTON (County)	Located In:	Corner Code #
1. Public Land Survey	T 3N R 6E	E-9
	T R	
	T R	
	T R	
2. Property Controlling in Section	S T R	
	S T R	
3. Miscellaneous Property in Sec.	S T R	
	S T R	

L.S.C.# 1040m
Register of Deeds Stamp & File Number

4. Lot No. _____, Recorded Plat _____
5. Private Claims _____

I, CHARLES E GARLOCK, in a field survey on JULY 14, 19 99 do hereby state that under requirements of P.A. 74, Michigan P.A. of 1970, the corner points mentioned in lines 1 and 2 above were in conformance with regulations and rules therefore as required in the current manual of survey instructions of the United States Department of the Interior, Bureau of Land Management or by a decree of a Court of Law and /or that the corner points mentioned in lines 3, 4 and 5 above were in conformance with the rules of the Michigan Board of Land Surveyors or by a Decree of a Court of Law; established, re-established, monumented, recovered, found as expressed below:

NOTE: Not more than 2 corners, all in the same town and range, may be recorded on this certificate.

1	A	B	C	D	E	F	G	H	I	J	K	L	M
2	6		5		4		3		2		1		
3													
4	7		8		9		10		11		12		
5													
6	18		17		16		15		14		13		
7													
8	19		20		21		22		23		24		
9													
10	30		29		28		27		26		25		
11													
12	31		32		33		34		35		36		
13													

A. Description of original monument and accessories and/or subsequent restoration:

GLO SURVEY DATED: MAY 24, 1823 BY S SIBLEY AND NONE OF THE GLO WITNESSES REMAIN.
GLO WITNESSES WO 6-N6 1/2 W-25.74'
WO 6-N82 1/2 W-20.46'

B. Description of corner evidence found and/or method applied in restoring or reestablishing corner:


FOUND BOAT SPIKE IN MON. BOX ABOUT 3' NORTH OF CONSTR. C/L

C. Description of monument for corner and accessories established to perpetuate locating the position of the corner:

E-9: NW COR. SEC. 28, T3N-R6E, HARTLAND TWP. LIV. CO. MI. CEMETED 1 1/4" X 6" I. PIPE OVER TOP OF FOUND BOAT SPIKE WITH LIV. CO. REMON. BRASS CAP ON TOP.
N4W-37.22'-SP & TAG W/S GUY POLE
SOUTH-44.82'-SP & TAG E/S U POLE
S7W-66.12'-SP & TAG E/S 6" MAPLE
S25W-35.41'-C/L MANHOLE COVER

Signed by Charles E. Garlock
Surveyor's Michigan License No. 14762

Date JULY 19, 1999

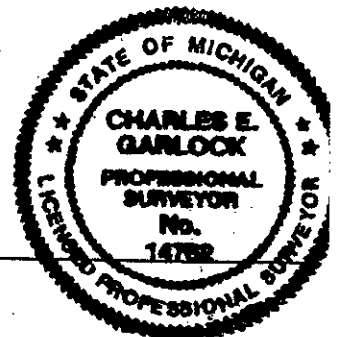

RA. 348 1988, APPROVED BY LIVINGSTON COUNTY
PEER GROUP ON 3-17-99 CO REP VED