

MAR 17 2000

FILED

SECTION

LAND CORNER RECORDATION CERTIFICATE
Filing Requirement of Act 74, Mich. P.A. 1970

1999 JUL 29 P 12: 27

NANCY HAVILAND
REGISTER OF DEEDS
LIVINGSTON COUNTY, MI.
48843

For corners in

LIVINGSTON (County)	Located In:	Corner Code #
1. Public Land Survey	T3N R 6E	E-10
	T R	
	T R	
	T R	
2. Property Controlling in Section	S T R	
	S T R	
3. Miscellaneous Property In Sec.	S T R	
	S T R	

9

L.S.C.# 1041m
Register of Deeds Stamp & File Number

4. Lot No. _____, Recorded Plat _____
5. Private Claims _____

I, CHARLES E GARLOCK, in a field survey on JULY 14, 1999 do hereby state that under requirements of P.A. 74, Michigan P.A. of 1970, the corner points mentioned in lines 1 and 2 above were in conformance with regulations and rules therefore as required in the current manual of survey instructions of the United States Department of the Interior, Bureau of Land Management or by a decree of a Court of Law and for that the corner points mentioned in lines 3, 4 and 5 above were in conformance with the rules of the Michigan Board of Land Surveyors or by a Decree of a Court of Law, established, re-established, monumented, recovered, found as expressed below:

	A	B	C	D	E	F	G	H	I	J	K	L	M
1													
2	6			5		4		3		2		1	
3													
4	7			8		9		10		11		12	
5													
6	18			17		16		15		14		13	
7													
8	19			20		21		22		23		24	
9													
10	30			29		28		27		26		25	
11													
12	31			32		33		34		35		36	
13													

NOTE: Not more than 2 corners, all in the same town and range, may be recorded on this certificate.

A. Description of original monument and accessories and/or subsequent restoration:
GLO SURVEY DATED: MAY 24, 1823 BY S SIBLEY AND NONE OF THE GLO WITNESSES REMAIN.
GLO WITNESSES BO 16-N34E-165.0'
HICK 10-N10W-141.24'


B. Description of corner evidence found and/or method applied in restoring or reestablishing corner:
FOUND 3/4" I. ROD COPPER CLAD W/MDOT 3" DIA CAP IN SE ROOT OF 36" OAK

C. Description of monument for corner and accessories established to perpetuate locating the position of the corner:
E-10: W 1/4 COR. SEC. 28, T3N-R6E, HARTLAND TWP. LIV. CO. MI. WITNESSED FOUND IRON.

- NORTH-1.41'-SP & TAG E/S 40" OAK
- N35E-17.93'-SP & TAG W/S 8" CHERRY
- N75E-22.47'-SP & TAG N/S FORKED 12" CHERRY
- S10E-22.95'-SP & TAG E/S DBL 12" OAK
- WEST-01.85'-SP & TAG S/S 40" OAK
- N35E-17.90'-SP & TAG W/S 8" CHERRY
- S10E-22.95'-SP 7 TAG W/S 12" DBL OAK

Signed by Charles E Garlock
Surveyor's Michigan License No. 14762

Date JULY 19, 1999

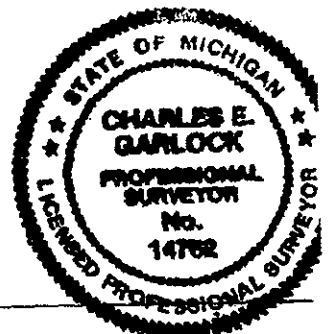

P.A. 345 1990, APPROVED BY LIVINGSTON COUNTY
PEER GROUP ON 4-7-1999 CO. REP JED