

MAR 17 2000

SECTION

LAND CORNER RECORDATION CERTIFICATE
Filing Requirement of Act 74, Mich. P.A. 1970

For corners in
LIVINGSTON
(County)

Located In: Corner Code #

- 1. Public Land Survey T 3N R 6E E11
 T R _____
 T R _____
 T R _____
- 2. Property Controlling S T R _____
 in Section S T R _____
- 3. Miscellaneous S T R _____
 Property in Sec. S T R _____

1999 JUL 29 P 12: 27

9/

NANCY HAVILAND
REGISTER OF DEEDS
LIVINGSTON COUNTY, MI.
48843

CLS # 1042m
Register of Deeds Stamp & File Number

- 4. Lot No. _____, Recorded Plat _____
- 5. Private Claims _____

I, CHARLES E GARLOCK, in a field survey on MAY 25, 19 99 do hereby state that under requirements of P.A. 74, Michigan P.A. of 1970, the corner points mentioned in lines 1 and 2 above were in conformance with regulations and rules therefore as required in the current manual of survey instructions of the United States Department of the Interior, Bureau of Land Management or by a decree of a Court of Law and for that the corner points mentioned in lines 3, 4 and 5 above were in conformance with the rules of the Michigan Board of Land Surveyors or by a Decree of a Court of Law; established, re-established, monumented, recovered, found as expressed below:

NOTE: Not more than 2 corners, all in the same town and range, may be recorded on this certificate.

A	B	C	D	E	F	G	H	I	J	K	L	M
1												
2	6	5	4	3	2	1						
3												
4	7	8	9	10	11	12						
5												
6	18	17	16	15	14	13						
7												
8	19	20	21	22	23	24						
9												
10	30	29	28	27	26	25						
11												
12	31	32	33	34	35	36						
13												


A. Description of original monument and accessories and/or subsequent restoration:
GLO SURVEY DATED: 5-24-1823 BY S SIBLEY AND NONE OF THE GLO WITNESSES REMAIN.
GLO WITNESSES: W08-N62½W-17.16'
W06-N21E-18.48'

B. Description of corner evidence found and/or method applied in restoring or reestablishing corner:
FOUND 1/2" I. ROD IN MON. BOX ABOUT 3 FT. NORTH OF ASPHALT ROAD C/L

C. Description of monument for corner and accessories established to perpetuate locating the position of the corner:
E11: SW COR. SEC. 28 T3N-R6E, HARTLAND TWP. LIV. CO. MI, REPLACED FOUND IRON WITH 1¼" X 36" I. PIPE WITH 6" BREAKAWAY TOP AND LIV. REMON. BRASS CAP ON TOP #14762 IN THE EXISTING MON. BOX
S47E-41.52'-SP & TAG NE/S 10" OAK
N5E-71.50'-SP & TAG W/S U. POLE
N70W-60.67'-SP & TAG S/S 40" OAK
N73W-95.05'-SP & TAG S/S 14" SPRUCE
SOUTH-3'-C/L ROAD
SOUTH-33.00'-1/2" I. ROD (TIPPED EAST)
NORTH-33.00'-3/4" I. PIPE AND CAP

Signed by Charles E. Garlock
Surveyor's Michigan License No. 14762

Date 5-25-99

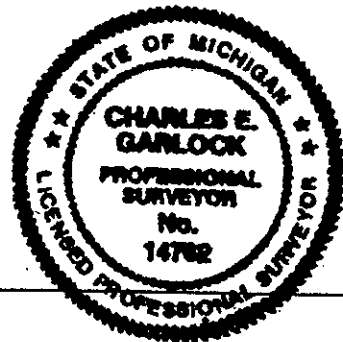

P.A. 345 1990, APPROVED BY LIVINGSTON COUNTY
PEER GROUP ON 4-7-1999 CO. REP JED