

MAR 17 2000

FILED

SECTION

LAND CORNER RECORDATION CERTIFICATE  
Filing Requirement of Act 74, Mich. P.A. 1970

For corners in

LIVINGSTON

(County)

Located in:

Corner Code #

1. Public Land Survey

T	<u>3N</u>	R	<u>6E</u>	E-12
T	_____	R	_____	_____
T	_____	R	_____	_____
T	_____	R	_____	_____
T	_____	R	_____	_____
S	_____	T	_____	_____
S	_____	T	_____	_____
S	_____	T	_____	_____
S	_____	T	_____	_____

2. Property Controlling in Section

3. Miscellaneous Property in Sec.

4. Lot No. \_\_\_\_\_, Recorded Plat \_\_\_\_\_

5. Private Claims \_\_\_\_\_

I, CHARLES E GARLOCK, in a field survey on JULY 14, 1999 do hereby state that under requirements of P.A. 74, Michigan P.A. of 1970, the corner points mentioned in lines 1 and 2 above were in conformance with regulations and rules therefore as required in the current manual of survey instructions of the United States Department of the Interior, Bureau of Land Management or by a decree of a Court of Law and/or that the corner points mentioned in lines 3, 4 and 5 above were in conformance with the rules of the Michigan Board of Land Surveyors or by a Decree of a Court of Law; established, re-established, monumented, recovered, found as expressed below:

NOTE: Not more than 2 corners, all in the same town and range, may be recorded on this certificate.

	A	B	C	D	E	F	G	H	I	J	K	L
1												
2	6			5		4		3		2		1
3												
4	7			8		9		10		11		12
5												
6	18			17		16		15		14		13
7												
8	19			20		21		22		23		24
9												
10	30			29		28		27		26		25
11												
12	31			32		33		34		35		36
13												


A. Description of original monument and accessories and/or subsequent restoration:

GLO SURVEY DATED: MAY 24, 1823 BY S SIBLEY AND NONE OF THE GLO WITNESSES REMAIN.  
GLO WITNESSES: TAM 6-N64E-29.70'  
TAM 10-N14W- 17.82'

B. Description of corner evidence found and/or method applied in restoring or reestablishing corner:  
FOUND 1/2" I. ROD IN 18" OF WATER

C. Description of monument for corner and accessories established to perpetuate locating the position of the corner:

E-12: W 1/4 COR. SEC. 33 T3N-R6E, HARTLAND TWP. LIV. CO. MI. SET 3/4" X 96" I. PIPE OVER FOUND 1/2" I. ROD AND CEMETED 1 1/2" X 6" I. PIPE W/ BRASS REMON CAP ON TOP, TOP OF IRON IS AT PLUS 18"  
S31E-149.38'-SP & TAG W/S 10" ASH  
S5E-175.66'-SP & TAG E/S 24" OAK  
S5W-135.76'-SP 7 TAG E/S 18" MAPLE  
S27W-125.15'-SP & TAG TRIPLE 36" MAPLE

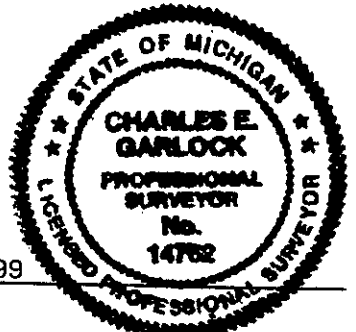

Signed by Charles E. Garlock  
Surveyor's Michigan License No. 14762

Date JULY 19, 1999

P.A. 345 1990, APPROVED BY LIVINGSTON COUNTY  
PEER GROUP ON 4-7-1999, CO. REP JEQ