

MAR 17 2000

FILED

SECTION

LAND CORNER RECORDATION CERTIFICATE
Filing Requirement of Act 74, Mich. P.A. 1970

1999 JUL 29 P 12:27

For corners in

LIVINGSTON

(County)

Located In:

Corner Code #

NANCY HAVILAND
REGISTER OF DEEDS
LIVINGSTON COUNTY, MI.
48843

9

- 1. Public Land Survey T3N R 6E G-10
 T R
 T R
 T R
- 2. Property Controlling S T R
 in Section S T R
- 3. Miscellaneous S T R
 Property in Sec. S T R

CLS # 1046m

Register of Deeds Stamp & File Number

- 4. Lot No. _____, Recorded Plat _____
- 5. Private Claims _____

I, CHARLES E GARLOCK, in a field survey on JULY 14, 1999 do hereby state that under requirements of P.A. 74, Michigan P.A. of 1970, the corner points mentioned in lines 1 and 2 above were in conformance with regulations and rules therefore as required in the current manual of survey instructions of the United States Department of the Interior, Bureau of Land Management or by a decree of a Court of Law and /or that the corner points mentioned in lines 3, 4 and 5 above were in conformance with the rules of the Michigan Board of Land Surveyors or by a Decree of a Court of Law; established, re-established, monumented, recovered, found as expressed below:

NOTE: Not more than 2 corners, all in the same town and range, may be recorded on this certificate.

| | | | | | | | | | | | | | |
|----|----|---|----|---|----|---|----|---|----|---|----|---|---|
| | A | B | C | D | E | F | G | H | I | J | K | L | M |
| 1 | | | | | | | | | | | | | |
| 2 | 6 | | 5 | | 4 | | 3 | | 2 | | 1 | | |
| 3 | | | | | | | | | | | | | |
| 4 | 7 | | 8 | | 9 | | 10 | | 11 | | 12 | | |
| 5 | | | | | | | | | | | | | |
| 6 | 18 | | 17 | | 16 | | 15 | | 14 | | 13 | | |
| 7 | | | | | | | | | | | | | |
| 8 | 19 | | 20 | | 21 | | 22 | | 23 | | 24 | | |
| 9 | | | | | | | | | | | | | |
| 10 | 30 | | 29 | | 28 | | 27 | | 26 | | 25 | | |
| 11 | | | | | | | | | | | | | |
| 12 | 31 | | 32 | | 33 | | 34 | | 35 | | 36 | | |
| 13 | | | | | | | | | | | | | |

A. Description of original monument and accessories and/or subsequent restoration:


GLO SURVEY DATED: MAY 24, 1823 BY S SIBLEY AND NONE OF THE GLO WITNESSES REMAIN.
GLO WITNESSES: W014-S57E-20.46'
W0 12- S48W-10.56'

B. Description of corner evidence found and/or method applied in restoring or reestablishing corner:

FOUND 1" IRON PIPE AT NE COR. OF HARTLAND SHORES ESTATES NO. 1, LIBER 12, PAGES 8 & 9

C. Description of monument for corner and accessories established to perpetuate locating the position of the corner:

G-10: E 1/4 COR. SEC. 28, T3N-R6E, HARTLAND TWP. LIV. CO. MI, REPLACED WITH 1 1/4" X 36" BREAKAWAY IRON PIPE WITH LIV. CO. REMON BRASS CAP ON TOP
NORTH-28.27'-SP & TAG W/S 13" CEDAR
N40E-64.30'-SP & TAG SW/S 24" OAK
N60E-55.86'-SP & TAG S/S 16" MAPLE
S40E-60.62'-SP & TAG N/S TRIPLE 12" CHERRY
WEST-0.98'-C/L 2" STEEL POST

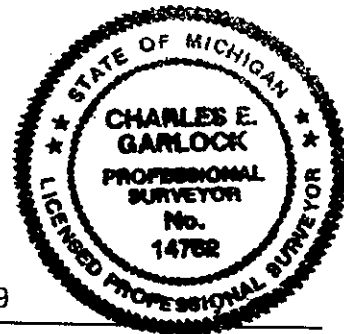

Signed by Charles E. Garlock
Surveyor's Michigan License No. 14762

Date JULY 19, 1999

P.A. 345 1990, APPROVED BY LIVINGSTON COUNTY
PEER GROUP ON 4-7-1999 CO. REP JED