

LAND CORNER RECORDATION CERTIFICATE
Filing Requirement of Act 74, Mich. P.A. 1970

For corners in

LIVINGSTON
(County)

Located In:

Corner Code I-06

- 1. Public Land Survey T 3N R 6E I-06
T _____ R _____
T _____ R _____
T _____ R _____
- 2. Property Controlling S _____ T _____ R _____
in Section S _____ T _____ R _____
- 3. Miscellaneous S _____ T _____ R _____
Property in Sec. S _____ T _____ R _____

OCT 7 11 09 AM '96
L.S.C. #552M
REGISTER OF DEEDS
LIVINGSTON COUNTY
48847

FILED

L.S.C. #552M

Register of Deeds Stamp & File Number

- 4. Lot No. _____ Recorded Plat _____
- 5. Private Claims _____

	A	B	C	D	E	F	G	H	I	J	K	L	M
2	6		5		4		3		2		1		
3													
4	7		8		9		10		11		12		
5													
6	18		17		16		15	●	14		13		
7													
8	19		20		21		22		23		24		
9													
10	30		29		28		27		26		25		
11													
12	31		32		33		34		35		36		
13													

I, Jack K. Smith, in a field survey on June 20, 1996, do hereby certify that under requirements of P.A. 74, Michigan P.A. of 1970, the corner points mentioned in lines 1 and 2 above were in conformance with regulations and rules therefore as required in the current manual of survey instructions of the United States Department of the Interior, Bureau of Land Management or by a decree of a Court of Law and/or that the corner points mentioned in lines 3, 4 and 5 above were in conformance with the rules of the Michigan Board of Land Surveyors or by a Decree of a Court of Law; established, re-established, monumented, re-monumented, recovered, found as expressed below:

NOTE: Not more than 4 corners, all in the same town and range, may be recorded on this certificate.

A. Description of original monument and accessories and/or subsequent restoration:

I-06 The West 1/4 Corner of Section 14, Hartland Township was set by the GLO in 1823 by Sylvester Sibley.
The original witnesses are:
W Oak 16" S62°E 16 lk (10.6')
W Oak 6" S74°W 19 lk (12.5')

NOTE: NONE OF THE ORIGINAL WITNESSES COULD BE FOUND OR PERPETUATED.
SEE THE BACK OF THIS SHEET FOR ADDITIONAL HISTORICAL DATA.

B. Description of corner evidence found and/or method applied in restoring or reestablishing corner:

I-06 Found 1/2" iron 3 feet west of the centerline of Bullard Road with an old tree row to the west and a fence line to the east.



C. Description of monument for corner and accessories established to perpetuate locating the position of the corner:

I-06 West 1/4 Corner, Section 14, T3N, R6E
Set 30" x 1 1/4" iron pipe with 6" x 1 1/4" break-off and brass cap marked as "Livingston County Monument Corner".


- N45°W Set nail and tag in NE side twin 10" Cherry 63.27'
- N45°E Set nail and tag in NW side 10" Oak 40.52'
- S88°E Set nail and tag in S side 18" Oak 31.04'
- S30°W Set nail and tag in E side twin 16" Oak 83.64'

Signed by [Signature] Date June 20, 1996
Surveyor's Michigan License No. 35999

April 12, 1996

I-06 T3N - R6E: WEST 1/4 CORNER, SECTION 14, HARTLAND TOWNSHIP

Found 1/2" iron 3 feet west of the centerline of Bullard Road that agrees with witnesses by Brad Thompson. The corner was originally recorded as being set by S. Sibley in 1823. Kostecke calls for a found 1/2" iron in 1973. One of his witnesses still checks but the others have been removed. There is a good, old tree row to the west and a fairly old fence to the east. A Finney/Carnahan 132 drawing reports a distance which is 9 feet longer than the general consensus measure on the north 1/2 of the West line of Section 14, but I could find no explanation for the difference. The site is masked for GPS and has limited sight distance to the south so it would not make a very desirable GPS point. Based on the usage of the current corner and the occupational evidence to support that location I recommend accepting I-06, the West 1/4 Corner of Section 14, at the location as is presently monumented.

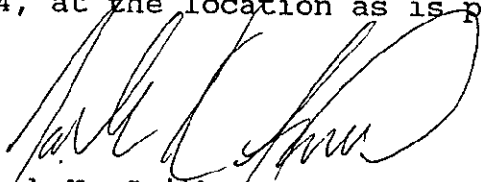

Jack K. Smith, PS
Desine Inc.

