

**SURVEY &  
REMONUMENTATION**

DEC 07 1994

**LAND CORNER RECORDATION CERTIFICATE**  
Filing Requirement of Act 74, Mich. P.A. 1970

For corners in **COMMISSION**  
**LIVINGSTON**  
(County)

Located In: Corner Code #

|                                    |   |            |   |            |             |
|------------------------------------|---|------------|---|------------|-------------|
| 1. Public Land Survey              | T | <u>3</u> N | R | <u>6</u> E | <u>I-13</u> |
|                                    | T | ___        | R | ___        | ___         |
|                                    | T | ___        | R | ___        | ___         |
|                                    | T | ___        | R | ___        | ___         |
| 2. Property Controlling in Section | S | ___        | T | ___        | R           |
|                                    | S | ___        | T | ___        | R           |
| 3. Miscellaneous Property in Sec.  | S | ___        | T | ___        | R           |
|                                    | S | ___        | T | ___        | R           |

4. Lot No. \_\_\_\_\_, Recorded Plat \_\_\_\_\_  
5. Private Claims \_\_\_\_\_

NANCY HAVILAND  
 REGISTER OF DEEDS  
 LIVINGSTON COUNTY, MI  
 48843  
 SEP 15 8 58 AM '94

FILED

L.S.C. #265m  
Register of Deeds Stamp & File Number

|    | A  | B  | C  | D  | E  | F  | G | H | I | J | K | L | M |
|----|----|----|----|----|----|----|---|---|---|---|---|---|---|
| 2  | 6  | 5  | 4  | 3  | 2  | 1  |   |   |   |   |   |   |   |
| 3  |    |    |    |    |    |    |   |   |   |   |   |   |   |
| 4  | 7  | 8  | 9  | 10 | 11 | 12 |   |   |   |   |   |   |   |
| 5  |    |    |    |    |    |    |   |   |   |   |   |   |   |
| 6  | 18 | 17 | 16 | 15 | 14 | 13 |   |   |   |   |   |   |   |
| 7  |    |    |    |    |    |    |   |   |   |   |   |   |   |
| 8  | 19 | 20 | 21 | 22 | 23 | 24 |   |   |   |   |   |   |   |
| 9  |    |    |    |    |    |    |   |   |   |   |   |   |   |
| 10 | 30 | 29 | 28 | 27 | 26 | 25 |   |   |   |   |   |   |   |
| 11 |    |    |    |    |    |    |   |   |   |   |   |   |   |
| 12 | 31 | 32 | 33 | 34 | 35 | 36 |   |   |   |   |   |   |   |
| 13 |    |    |    |    |    |    |   |   |   |   |   |   |   |

I, Jack K. Smith, in a field survey on September 4, 1994, do hereby certify that under requirements of P.A. 74, Michigan P.A. of 1970, the corner points mentioned in lines 1 and 2 above were in conformance with regulations and rules therefore as required in the current manual of survey instructions of the United States Department of the Interior, Bureau of Land Management or by a decree of a Court of Law and/or that the corner points mentioned in lines 3, 4 and 5 above were in conformance with the rules of the Michigan Board of Land Surveyors or by a Decree of a Court of Law; established, re-established, monumented, re-monumented, recovered, found as expressed below:

**NOTE: Not more than 4 corners, all in the same town and range, may be recorded on this certificate.**


A. Description of original monument and accessories and/or subsequent restoration:

I-13 The Southwest Corner of Section 35, Hartland Township was set by the GLO in 1823 by S. Sibley.  
The original witnesses are:  
B. Oak 18" N62W 59 lks  
B. Oak 18" N55E 32 lks

**NOTE: NONE OF THE ORIGINAL WITNESSES COULD BE FOUND OR PERPETUATED SEE THE BACK OF THIS SHEET FOR ADDITIONAL HISTORICAL DATA.**

B. Description of corner evidence found and/or method applied in restoring or reestablishing corner:

I-13 Found 1" iron bar 50-60 feet north of Commerce Road. The Northwest Corner of Section 2, Brighton Township is a 1/2" iron rod 85.8 feet east of this corner.

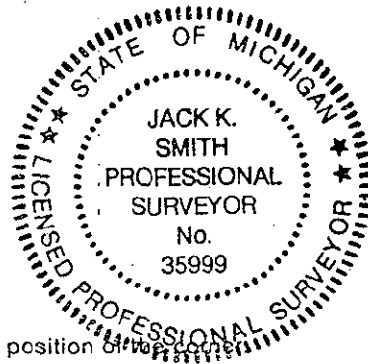

C. Description of monument for corner and accessories established to perpetuate locating the position of the corner:


I - 13 Southwest Corner, Section 35, T3N, R6E  
Set 36" x 1 1/4" iron pipe with brass cap marked as "Livingston County Monument Corner"  
S85°E Nail and tag in N side 10" twin Elm 41.18'  
N84°W Nail and tag in N side 6" Maple 23.97'  
S15°W Nail and tag in W side 8" Maple 23.00'  
S45°W Nail and tag in E side 14" Oak 42.27'

Signed by Jack K. Smith Date September 10, 1994

March 12, 1994

I-13, T3N, R6E: SOUTHWEST CORNER, SECTION 35, HARTLAND TOWNSHIP

Found 1" Iron Bar 50-60 feet north of Commerce Road. The Northwest Corner of Section 2, Brighton Township is a 1/2" iron rod 85.8 feet east of this corner, this falling matches the original GLO call. There is a large tree row and fence running south from the Brighton Township corner. There is no obvious occupation from the Hartland corner in any direction. The corner was originally established by Sibley in 1823 for the GLO. In 1983 Kostecke measured 1.30 feet longer than present measure on the South 1/2 of the West line of Section 35, and I could find no explanation for this discrepancy other than the difficulty of measurement in the swamplands surrounding this area to the north. Boss Engineering surveyed Section 35 in 1988, and their distances along the West and South lines match within 2-3 tenths of a foot with present measure. A sweep of the area surrounding this corner did not reveal any additional irons. I recommend acceptance I-13, the Southwest Corner of Section 35, at the location as is presently monumented by the 1" iron bar.

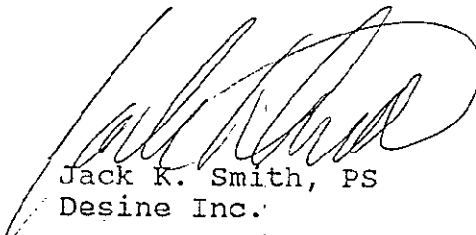  
Jack K. Smith, PS  
Desine Inc.

