

**SURVEY &
REMONUMENTATION**

DEC 07 1994

LAND CORNER RECORDATION CERTIFICATE
Filing Requirement of Act 74, Mich. P.A. 1970

For corners in **COMMISSION**
LIVINGSTON
(County)

Located In: Corner Code **J-13**

- | | | |
|------------------------------------|---------------------------|-------------|
| 1. Public Land Survey | T <u>3</u> N R <u>6</u> E | <u>J-13</u> |
| | T _____ R _____ | _____ |
| | T _____ R _____ | _____ |
| | T _____ R _____ | _____ |
| 2. Property Controlling in Section | S _____ T _____ R _____ | _____ |
| | S _____ T _____ R _____ | _____ |
| 3. Miscellaneous Property in Sec. | S _____ T _____ R _____ | _____ |
| | S _____ T _____ R _____ | _____ |

SEP 15 8 59 AM '94
 NANCY HAVILAND
 REGISTER OF DEEDS
 LIVINGSTON COUNTY, MI
 48843

FILED

L.S.C. #268m
Register of Deeds Stamp & File Number

4. Lot No. _____, Recorded Plat _____
5. Private Claims _____

A	B	C	D	E	F	G	H	I	J	K	L	M
2	6	5	4	3	2	1						
3												
4	7	8	9	10	11	12						
5												
6	18	17	16	15	14	13						
7												
8	19	20	21	22	23	24						
9												
10	30	29	28	27	26	25						
11												
12	31	32	33	34	35	36						
13												

I, Jack K. Smith, in a field survey on September 4, 19 94, do hereby certify that under requirements of P.A. 74, Michigan P.A. of 1970, the corner points mentioned in lines 1 and 2 above were in conformance with regulations and rules therefore as required in the current manual of survey instructions of the United States Department of the Interior, Bureau of Land Management or by a decree of a Court of Law and/or that the corner points mentioned in lines 3, 4 and 5 above were in conformance with the rules of the Michigan Board of Land Surveyors or by a Decree of a Court of Law; established, re-established, monumented, re-monumented, recovered, found as expressed below:

NOTE: Not more than 4 corners, all in the same town and range, may be recorded on this certificate.

A. Description of original monument and accessories and/or subsequent restoration:

J-13 The South 1/4 Corner of Section 35, Hartland Township was NOT set by the GLO in 1823 (see notes on back of this page).

NOTE: SEE THE BACK OF THIS SHEET FOR HISTORICAL DATA.

B. Description of corner evidence found and/or method applied in restoring or reestablishing corner:

J-13 Set corner at the midpoint on the South line of Section 35.



C. Description of monument for corner and accessories established to perpetuate locating the position of the corner:

J-13 South 1/4 Corner, Section 35, T3N, R6E
 Set 36" x 1 1/4" iron pipe with brass cap marked as "Livingston County Monument Corner" in swamp.


S88°12'E	N 1/4 Cor. Sec. 2 Brighton Twp.	33.31'
S01°24'W	36" x 1" iron pipe with Liv. Co. Wit cap	216.62'
S08°20'W	36" x 1" iron pipe with Liv. Co. Wit cap	210.59'
S17°31'W	36" x 1" iron pipe with Liv. Co. Wit cap	231.76'

Signed by [Signature] Date September 10, 1994

March 12, 1994

J-13, T3N, R6E: SOUTH 1/4 CORNER, SECTION 35, HARTLAND TOWNSHIP

The South 1/4 Corner of Section 35 was never placed by the GLO. The notes call for entering a "vary bad swamp" at 45 chains, but I believe that the correct distance was 25 chains from looking at the aerial photo and the fact that no post was set at the 40 chain mark (this has also been substantiated by "GLO" notes as transcribed and kept by C. Garlock). The North 1/4 Corner of Section 2, Brighton Township is a pipe set in the water. This pipe, as well as fenceline to the south is shown in the survey of the GM proving grounds from 1954 as the North 1/4 Corner of Section 2, Brighton. There is no northerly occupation in this area or for 1000 feet or more to the north due to swamp, but there is occupation to the south on the south side of Commerce Road. Boss Engineering has used the North 1/4 Corner of Section 2, Brighton as the South 1/4 Corner of Section 35, Hartland, although the Center as shown on the same survey is not on the North-South 1/4 line, and would much more closely agree with using the midpoint of the South line of Section 35. The North 1/4 Corner of Section 2, Brighton falls 1.1 feet south of the straight line between the SW and SE Corners of Section 35. There is old east-west fence 300 feet or so to the east which is approximately on the section line, but is shown to vary on the GM proving grounds survey. A sweep of the area found no additional irons. I recommend setting J-13, the South 1/4 Corner of Section 35, at the midpoint on the South line of Section 35, Hartland.

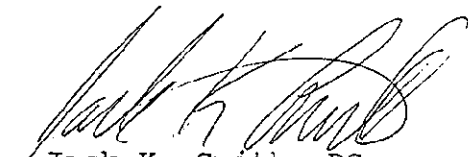

Jack K. Smith, PS
Desine Inc.

