

LAND CORNER RECORDATION CERTIFICATE  
Filing Requirement of Act 74, Mich. P.A. 1970

OCT 17 10 34 AM '95  
NANCY HAVILAND  
REGISTER OF DEEDS  
LIVINGSTON COUNTY, MI  
48843

FILED

corners in  
LIVINGSTON  
(County)

Located In: Corner Code #/

Public Land Survey	T	3N	R	6E	K-07
	T		R		
	T		R		
	T		R		
Property Controlling in Section	S		T	R	
	S		T	R	
Miscellaneous Property in Sec.	S		T	R	
	S		T	R	

L.S.C.# 509m

Register of Deeds Stamp & File Number

Lot No. \_\_\_\_\_, Recorded Plat \_\_\_\_\_  
Private Claims \_\_\_\_\_

Jack K. Smith, in a field survey on October 10, 1995

A	B	C	D	E	F	G	H	I	J	K	L	M
2	6	5	4	3	2	1						
3												
4	7	8	9	10	11	12						
5												
6	15	17	16	15	14	13						
7												
8	19	20	21	22	23	24						
9												
10	30	29	28	27	26	25						
11												
12	31	32	33	34	35	36						
13												

hereby certify that under requirements of P.A. 74, Michigan P.A. of 1970, the corner points mentioned in lines 1 and 2 above were in conformance with regulations and rules therefore as required in the current manual of survey instructions of the United States Department of the Interior, Bureau of Land Management or by a decree of a Court of Law and/or that the corner points mentioned in lines 3, 4 and 5 above were in conformance with the rules of the Michigan Board of Land Surveyors or by a Decree of a Court of Law; established, re-established, monumented, re-monumented, recovered, found as expressed below:


NOTE: Not more than 4 corners, all in the same town and range, may be recorded on this certificate.

Description of original monument and accessories and/or subsequent restoration:  
K-07 The Northwest Corner of Section 24, Hartland Township was set by the GLO in 1823 by S. Sibley.  
The original witnesses are:  
W Oak 12" S88 1/2°E 29 lk (19.1')  
B Oak 6" N58 1/2°W 51 lk (33.7')

NOTE: NONE OF THE ORIGINAL WITNESSES COULD BE FOUND OR PERPETUATED.  
SEE THE BACK OF THIS SHEET FOR ADDITIONAL HISTORICAL DATA.

Description of corner evidence found and/or method applied in restoring or reestablishing corner:  
K-07 Found T iron 2' west of centerline.

SURVEY &  
REMONUMENTATION  
NOV 27 1995  
COMMISSION

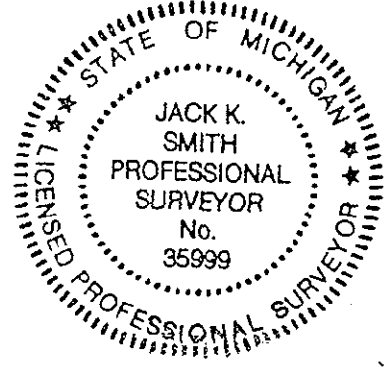


Description of monument for corner and accessories established to perpetuate locating the position of the corner:  
K-07 Northwest Corner, Section 24, T3N, R6E  
Set 30" x 1 1/4" iron pipe with 6" x 1 1/4" break-off and brass cap marked as "Livingston County Monument Corner" in monument box.  
S45°E Set nail and tag in NE side 6" Cedar 61.22'  
N70°E Set nail and tag in S side 26" Ash 81.41'  
N35°W Set nail and tag in NE side 14" Maple 66.35'  
S65°W Set nail and tag in SE side 14" Ash 107.54'

Signed by Jack K. Smith Date October 15, 1995  
Surveyor's Michigan License No. 35999  
P.A. 345 1990, APPROVED BY LIVINGSTON COUNTY

June 20, 1995

K-07 T3N - R6E: NORTHWEST CORNER, SECTION 24, HARTLAND TOWNSHIP

We found a "T" iron in the asphalt at the intersection of Fenton Road and Dunham Road (2 feet west of centerline Fenton Road). The corner was originally recorded as being set by S. Sibley in 1823. The corner is shown as a stone, plow point, brick and iron in notes of Teller from 1878. On notes from the Garlock Office there is a note from 1936 calling for finding the old iron and replacing it with a 1" round iron with new witnesses. Two of those witnesses agree with witnesses by Boss of 1972 calling for a "T" iron. Those witnesses in turn can be traced to 1985 witnesses of Phillips and extended to the witnesses to the present. This corner has been used by Boss, Bunno, Desine, Garlock, Newman, Phillips and Thompson, and witnesses and distances compare very well. A sweep of the area did not reveal any additional irons. This corner is open for GPS occupation. I recommend accepting K-07, the Northwest Corner of Section 24, at the location as is presently monumented.

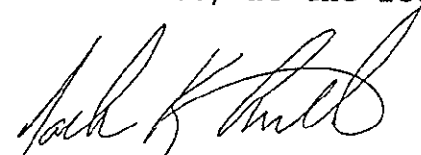  
Jack K. Smith, PS  
Desine Inc.

