

SURVEY & REMONUMENTATION

DEC 07 1994

LAND CORNER RECORDATION CERTIFICATE
Filing Requirement of Act 74, Mich. P.A. 1970

SEP 15 8 59 AM '94
 NANCY HAYLAND
 REGISTER OF DEEDS
 LIVINGSTON COUNTY, MI
 48843

FILED

For corners in **COMMISSION**
LIVINGSTON
(County)

Located In: Corner Code #

- 1. Public Land Survey T 3N R 6E K-09
- T _____ R _____
- T _____ R _____
- T _____ R _____
- 2. Property Controlling S _____ T _____ R _____
- in Section S _____ T _____ R _____
- 3. Miscellaneous S _____ T _____ R _____
- Property in Sec. S _____ T _____ R _____

L.S.C.#269m
Register of Deeds Stamp & File Number

- 4. Lot No. _____, Recorded Plat _____
- 5. Private Claims _____

	A	B	C	D	E	F	G	H	I	J	K	L	M
2	6		5		4		3		2		1		
3													
4	7		8		9		10		11		12		
5													
6	13		17		16		15		14		13		
7													
8	19		20		21		22		23		24		
9													
10	30		29		28		27		26		25		
11													
12	31		32		33		34		35		36		
13													

I, Jack K. Smith, in a field survey on September 4, 19 94, do hereby certify that under requirements of P.A. 74, Michigan P.A. of 1970, the corner points mentioned in lines 1 and 2 above were in conformance with regulations and rules therefore as required in the current manual of survey instructions of the United States Department of the Interior, Bureau of Land Management or by a decree of a Court of Law and/or that the corner points mentioned in lines 3, 4 and 5 above were in conformance with the rules of the Michigan Board of Land Surveyors or by a Decree of a Court of Law; established, re-established, monumented, re-monumented, recovered, found as expressed below:

NOTE: Not more than 4 corners, all in the same town and range, may be recorded on this certificate.

A. Description of original monument and accessories and/or subsequent restoration:

K-09 The Northwest Corner of Section 25, Hartland Township was set by the GLO in 1823 by S. Sibley.
The original witnesses are:
W. Oak 36" N66E 55 lks
W. Oak 34" N36W 18 lks

NOTE: NONE OF THE ORIGINAL WITNESSES COULD BE FOUND OR PERPETUATED
SEE THE BACK OF THIS SHEET FOR ADDITIONAL HISTORICAL DATA.

B. Description of corner evidence found and/or method applied in restoring or reestablishing corner:

K-09 Found 1" iron in a monument box 7'± south of the centerline of eastbound M-59 on the centerline of Pleasant Valley Road.



C. Description of monument for corner and accessories established to perpetuate locating the position of the corner:

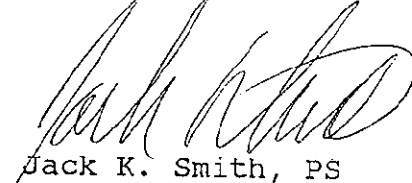
K-9 Northwest Corner, Section 25, T3N, R6E
1" iron with brass cap marked as "Livingston County Monument Corner"
S53°E 36" x 1" pipe with brass cap 52.20'
S52°W 36" x 1" pipe with brass cap 60.15'
N45°W 36" x 1" pipe with brass cap 55.98'
N41°E 36" x 1" pipe with brass cap 48.50'

signed by [Signature] Date September 10, 1994

June 12, 1994

K-09 T3N - R6E: NORTHWEST CORNER, SECTION 25, HARTLAND TOWNSHIP

We found a 1" iron in a monument box 7'± south of the centerline of eastbound M-59 and on the centerline of Pleasant Valley Road. The corner was originally recorded as being set by S. Sibley in 1823. This corner is shown on old County surveyor notes with one witness from 1885 Bullock records. The corner is shown on a Boss 132 of 1974 as a nail and cap found 6.6' south of centerline. A 74 by Douglas Hooth from 1976 calls for the corner as a 1" iron rod that he raised to the surface. Measured distance fit well with those shown on surveys by Boss (1979 and 1980). any evidence of tree rows or fences has been obliterated by road construction. A sweep of the area did not reveal any additional irons. I recommend accepting K-09, the Northwest Corner of Section 25, at the location as is presently monumented.


Jack K. Smith, PS
Desine Inc.

