

LAND CORNER RECORDATION CERTIFICATE
Filing Requirement of Act 74, Mich. P.A. 1970

OCT 17 10 33 AM '95
 HANCOCK HAVILLAND
 REGISTER OF DEEDS
 LIVINGSTON COUNTY, MI
 48843

FILED

For corners in LIVINGSTON (County) Located In: _____ Corner Code # _____

Public Land Survey T 3N R 6E L-05
 T _____ R _____
 T _____ R _____
 T _____ R _____

Property Controlling S _____ T _____ R _____
 in Section S _____ T _____ R _____

Miscellaneous S _____ T _____ R _____
 Property in Sec. S _____ T _____ R _____

L.S.C.# 507m
 Register of Deeds Stamp & File Number

Lot No. _____, Recorded Plat _____
 Private Claims _____

A	B	C	D	E	F	G	H	I	J	K	L	M
2	6	5	4	3	2	1						
3												
4	7	8	9	10	11	12						
5												
6	18	17	16	15	14	13						
7												
8	19	20	21	22	23	24						
9												
10	30	29	28	27	26	25						
11												
12	31	32	33	34	35	36						
13												

Jack K. Smith, in a field survey on October 10, 1995,
 do hereby certify that under requirements of P.A. 74, Michigan P.A. of 1970, the corner points mentioned
 in lines 1 and 2 above were in conformance with regulations and rules therefore as required in the
 current manual of survey instructions of the United States Department of the Interior, Bureau of Land
 Management or by a decree of a Court of Law and/or that the corner points mentioned in lines 3, 4 and 5
 above were in conformance with the rules of the Michigan Board of Land Surveyors or by a Decree of a
 Court of Law; established, re-established, monumented, re-monumented, recovered, found as
 expressed below:

NOTE: Not more than 4 corners, all in the same town and range, may be recorded
 on this certificate.

A. Description of original monument and accessories and/or subsequent restoration:
 L-05 The North 1/4 Corner of Section 13, Hartland Township was set by the
 GLO in 1823 by S. Sibley.
 The original witnesses are:
 W Oak 7" N23°E 49 lk (32.3')
 W Oak 7" S84°E 1.16 Ch (76.6')

NOTE: NONE OF THE ORIGINAL WITNESSES COULD BE FOUND OR PERPETUATED
 SEE THE BACK OF THIS SHEET FOR ADDITIONAL HISTORICAL DATA.

B. Description of corner evidence found and/or method applied in restoring or reestablishing corner:
 L-05 Found 1/2" iron on centerline.

SURVEY &
 REMONUMENTATION
 NOV 27 1995
 COMMISSION



C. Description of monument for corner and accessories established to perpetuate locating the position of the corner:
 L-05 North 1/4 Corner, Section 13, T3N, R6E
 Set 30" x 1 1/4" iron pipe with 6" x 1 1/4" break-off and brass cap marked
 as "Livingston County Monument Corner".

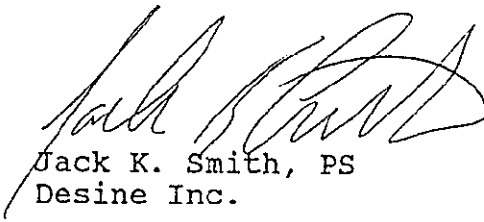
N55°E Set nail and tag in SE side twin 14" & 8" Hickory 57.74'
 S50°E Set nail and tag in N side 8" Cherry 54.87'
 S02°E Set nail and tag in E side 14" Sassafras 30.20'
 S20°W Set nail and tag in E side 8" Cherry 23.84'

Signed by [Signature] Date October 15, 1995
 Surveyor's Michigan License No. 35999

June 20, 1995

L-05 T3N - R6E: NORTH 1/4 CORNER, SECTION 13, HARTLAND TOWNSHIP

We found a 1/2" iron on the centerline of Hibner Road (gravel). There is very weak occupation to the north. The corner was originally recorded as being set by S. Sibley in 1823. This corner is shown on a survey from 1878/1879 by Teller with two witnesses (now gone) in which he calls for the setting of the corner on the North line at 1/2 distance between the NW and NE Corners (the current corner is 8 feet west of 1/2 distance). Boss Engineering calls for a distance of 2735.08 feet to the Northeast Corner in 1982 but reports a distance of 2733.49 feet in 1983 which matches current measure. There are no Act 74s recorded for the Corner at the present time. We dug this iron up and excavated to undisturbed soil but found no other corner evidence. A sweep of the area did not reveal any additional irons. This corner is open for GPS occupation. I recommend accepting L-05, the North 1/4 Corner of Section 13, at the location as is presently monumented.


Jack K. Smith, PS
Desine Inc.

