

1993

COMMISSION

LAND CORNER RECORDATION CERTIFICATE
Filing Requirement of Act 74, Mich. P.A. 1970

For corners in

LIVINGSTON
(County)

Located In:

Corner Code ##

- 1. Public Land Survey T 3N R 6E L-11
- T R
- T R
- T R
- 2. Property Controlling S T R
- in Section S T R
- 3. Miscellaneous S T R
- Property in Sec. S T R

Dec 28 4 35 PM '93
NANCY HAYLAND
REGISTER OF DEEDS
LIVINGSTON COUNTY, MI
48843

FILED

L.S.C. #152m
Register of Deeds Stamp & File Number

- 4. Lot No. _____, Recorded Plat _____
- 5. Private Claims _____

	A	B	C	D	E	F	G	H	I	J	K	L	M
2	6		5		4		3		2		1		
3													
4	7		8		9		10		11		12		
5													
6	18		17		16		15		14		13		
7													
8	19		20		21		22		23		24		
9													
10	30		29		28		27		26		25		
11													
12	31		32		33		34		35		36		
13													

MARY A. BARNWELL

I, MARY A. BARNWELL, in a field survey on DECEMBER 6, 19 93, do hereby certify that under requirements of P.A. 74, Michigan P.A. of 1970, the corner points mentioned in lines 1 and 2 above were in conformance with regulations and rules therefore as required in the current manual of survey instructions of the United States Department of the Interior, Bureau of Land Management or by a decree of a Court of Law and/or that the corner points mentioned in lines 3, 4 and 5 above were in conformance with the rules of the Michigan Board of Land Surveyors or by a Decree of a Court of Law; established, re-established, monumented, re-monumented, recovered, found as expressed below:

NOTE: Not more than 4 corners, all in the same town and range, may be recorded on this certificate.

A. Description of original monument and accessories and/or subsequent restoration:

L-11 The North 1/4 Corner of Section 36, Hartland Township was set by the GLO in 1815 by Joseph Wampler.
The original witnesses are:
W. Oak 22" N25E 36 lks
W. Oak 26" S62W 64 lks

NOTE: NONE OF THE ORIGINAL WITNESSES COULD BE FOUND OR PERPETUATED
SEE THE BACK OF THIS SHEET FOR ADDITIONAL HISTORICAL DATA.

B. Description of corner evidence found and/or method applied in restoring or reestablishing corner:

L-11 Found 1/2" iron rod in the centerline of Lone Tree Road on the approximate centerline of a fence line and tree row to the south.


NOTE : SEE THE DOSSIER AS FILED FOR THE LIVINGSTON COUNTY
REMONUMENTATION PROGRAM FOR ADDITIONAL INFORMATION
CONCERNING THIS CORNER.

C. Description of monument for corner and accessories established to perpetuate locating the position of the corner:

North 1/4 Corner, Section 36, T3N, R6E
Set 30" x 1 1/4" iron pipe with 6" break-off pipe and brass cap marked as "Livingston County Monument Corner"
N55°E Nail and tag in NE side 36" Maple 41.12'
NORTH Nail and tag in W side 18" Cherry 27.54'
N45°W Nail and tag in SE side 34" Maple 42.67'
SOUTH Nail and tag in W side 18" Maple 24.88'

APPROVED BY THE LIVINGSTON COUNTY MONUMENTATION PEER GROUP OCT. 30 1993.

Signed by Mary A. Barnwell
Surveyor's Michigan License No. 33971

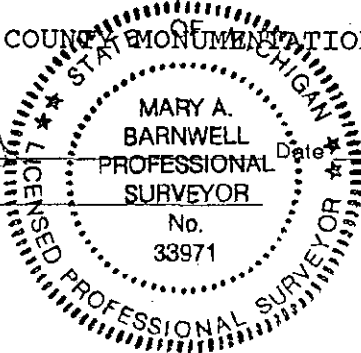


Date DECEMBER 24, 1993

October 30, 1993

L-11, T3N, R6E: NORTH 1/4 CORNER, SECTION 36, HARTLAND TOWNSHIP

Found 1/2" Iron Rod at the approximate intersection of the centerline of an east-west gravel road with a fence line / tree row going south. No occupation to the north. There is a dip in the land to the east and the terrain is gently rolling to the west. An Act 74 was filed by Boss in 1980 for this iron, which they used in Surveys in 1986 and 1991. The same iron was used in a Survey by Donald W. Ross in 1989. The iron is located approximately 10.0 feet west of the midpoint of the Section Line. A sweep of the area found no additional irons. I recommend accepting the North 1/4 Corner at the location as is presently monumented.


Mary A. Barnwell, PS
Desine Inc.

