

9-

FILED

LAND CORNER RECORDATION CERTIFICATE
Filing Requirement of Act 74, Mich. P.A. 1970

For corners in

LIVINGSTON
(County)

Located In:

Corner Code #

1. Public Land Survey

T 4N R 3E B-11
T _____ R _____
T _____ R _____
T _____ R _____

2. Property Controlling in Section

S _____ T _____ R _____
S _____ T _____ R _____

3. Miscellaneous Property in Sec.

S _____ T _____ R _____
S _____ T _____ R _____

4. Lot No. _____, Recorded Plat _____
5. Private Claims _____

1996 NOV 14 P 1:22


NANCY HAVILAND
REGISTER OF DEEDS
LIVINGSTON COUNTY, MI.
40843

L.S.C.#590m

Register of Deeds Stamp & File Number

I, DARRELL HUGHES, in a field survey on 10-29, 1996, do hereby state that under requirements of P.A. 74, Michigan P.A. of 1970, the corner points mentioned in lines 1 and 2 above were in conformance with regulations and rules therefore as required in the current manual of survey instructions of the United States Department of the Interior, Bureau of Land Management or by a decree of a Court of Law and/or that the corner points mentioned in lines 3, 4 and 5 above were in conformance with the rules of the Michigan Board of Land Surveyors or by a Decree of a Court of Law; established, re-established, monumented, recovered, found as expressed below:

NOTE: Not more than 2 corners, all in the same town and range, may be recorded on this certificate.

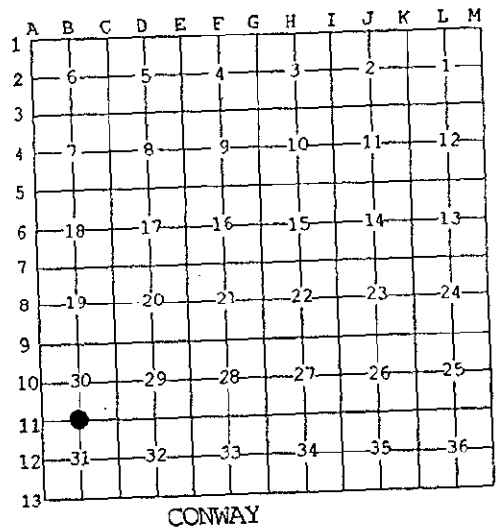

A. Description of original monument and accessories and/or subsequent restoration:

GLO: 1825
Black Ash 7", North 41 degrees East, 221 links
Elm 10", South 89 degrees West, 285 links

B. Description of corner evidence found and/or method applied in restoring or reestablishing corner:

Found 1/2" smooth iron rod

*Additional descriptions and historical information on back of this sheet.

C. Description of monument for corner and accessories established to perpetuate locating the position of the corner:

B-11, T4N, R3E, CONWAY, replaced existing corner with 1-1/4" X 36" iron pipe, affixed with 2" dia. brass cap, stamped "Livingston Co. Monumentation Corner, P.S. 19834, and is accepted as a careful and faithful perpetuation of the position of the original corner.
254 DEG. 54.76' SET NAIL/TAG NW/S 18" ASH.
098 DEG. 98.55' SET NAIL/TAG N/S 24" POPLAR.
204 DEG. 60.14' SET NAIL/TAG E/S 24" MAPLE.
360 DEG. 75.42' SET NAIL/TAG E/S UTILITY POLE.
090 DEG. 13'+/- CL 5' DIA. CMP CULVERT.

Signed by [Signature]
Surveyor's Michigan License No. 19834

Date October 29, 1996

PA. 345 1990, APPROVED BY LIVINGSTON COUNTY
PEER GROUP ON 7-17-96 CO. REP JED

FORM APPROVED BY MICHIGAN STATE BOARD OF PROFESSIONAL SURVEYORS, JAN. 28, 1971
REVISED MAY 14, 1975
REVISED JAN., 1983
REVISED OCT., 1995

CONWAY TOWNSHIP, T4N, R3E

B-11, THE SOUTH 1/4 CORNER OF SECTION 30 AND THE NORTH 1/4 CORNER OF SECTION 31.

FIELD: 6-21-1996 DARRELL D. HUGHES AND ASSOCIATES, FOWLerville.

Found 1/2" smooth iron rod in centerline Chase Lake Road. 0.2' below gravel road grade. Boss reset 1/2" iron rod in 1979 from survey by Hendryx. Witness' and corner have been perpetuated to present. I recommend, to the peer group, the acceptance of this iron for the position of B-11. Marginal for GPS.

1825 Sylvester Sibley, Deputy U.S. Surveyor "West between Sections 30 & 31, 40.00 chains, set 1/4 section post in swamp". P.7

1979 March Gary Boss files Act 74 stating "Set 1/2" iron per previous survey by LaVerne Hendryx, Job #13020" P.8

1979 Aug. Boss survey in SW 1/4 Sec. 30 using corner. Distances North to B-10 checks 1872 Bullock and distance West to A-11 checks GLO. P.9-9C

1983 Boss survey showing corner with same witness' P.10-10A.

1984 Hughes survey checks Boss witness' and 33' iron to North. P.11

1986 Boss surveys in SW 1/4 Sec.30 copies 1979 witness'. P.12-12D

1991 Hughes survey remeasures witness'. P.13-13A

1996 Witness comparison list. P.14