

LAND CORNER RECORDATION CERTIFICATE
Filing Requirement of Act 74, Mich. P.A. 1970

**9-
FILED**

For corners in

<u>LIVINGSTON</u> (County)	Located in:	Corner Code #
1. Public Land Survey	T <u>4N</u> R <u>3E</u>	<u>C-9</u>
	T _____ R _____	_____
	T _____ R _____	_____
	T _____ R _____	_____
2. Property Controlling in Section	S _____ T _____ R _____	_____
	S _____ T _____ R _____	_____
3. Miscellaneous Property in Sec.	S _____ T _____ R _____	_____
	S _____ T _____ R _____	_____
4. Lot No. _____, Recorded Plat _____		
5. Private Claims _____		

1996 NOV 14 P 1:22


NANCY HAVILAND
REGISTER OF DEEDS
LIVINGSTON COUNTY, MI.
48043

L.S.C. #592m

Register of Deeds Stamp & File Number

I, DARRELL HUGHES, in a field survey on 11-5, 1996, do hereby state that under requirements of P.A. 74, Michigan P.A. of 1970, the corner points mentioned in lines 1 and 2 above were in conformance with regulations and rules therefore as required in the current manual of survey instructions of the United States Department of the Interior, Bureau of Land Management or by a decree of a Court of Law and/or that the corner points mentioned in lines 3, 4 and 5 above were in conformance with the rules of the Michigan Board of Land Surveyors or by a Decree of a Court of Law; established, re-established, monumented, recovered, found as expressed below:

NOTE: Not more than 2 corners, all in the same town and range, may be recorded on this certificate.

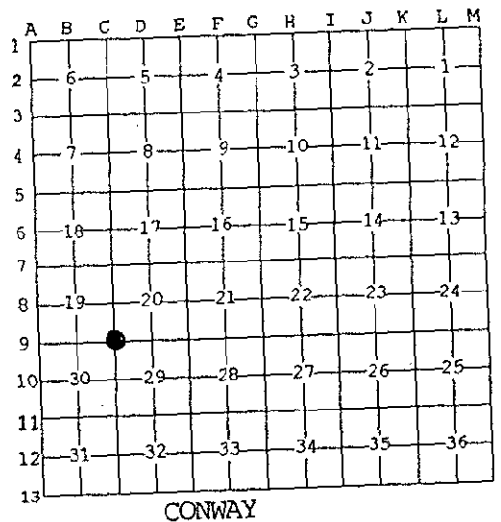

A. Description of original monument and accessories and/or subsequent restoration:

GLO: 1825
White Oak 16", North 63-1/2 degrees East, 19 links
White Oak 24", North 71-1/2 degrees West, 35 links

B. Description of corner evidence found and/or method applied in restoring or reestablishing corner:

Found 1" square bar 1.7 ft. long with two horseshoes lying as "ringers" around base, also embedded in pile of 6" stones at base.


*Additional descriptions and historical information on back of this sheet.

C. Description of monument for corner and accessories established to perpetuate locating the position of the corner:

C-9, T4N, R3E, CONWAY, replaced existing corner with 1-1/4" X 36" iron pipe, affixed with 2" dia. brass cap, stamped "Livingston Co. Monumentation Corner, P.S. 19834, and is accepted as a careful and faithful perpetuation of the position of the original corner.
104 DEG. 220.72' SET NAIL/TAG N/S 50" BURR OAK.
313 DEG. 48.67' SET NAIL/TAG SW/S UTILITY POLE.
196 DEG. 173.36' SET NAIL/TAG W/S UTILITY POLE.
248 DEG. 110.88' SET NAIL/TAG N/S 12" ASH.

Signed by Darrell Hughes
Surveyor's Michigan License No. 19834

Date November 5, 1996

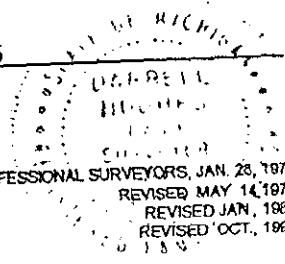

FORM APPROVED BY MICHIGAN STATE BOARD OF PROFESSIONAL SURVEYORS, JAN. 23, 1971
REVISED MAY 14, 1975
REVISED JAN. 1983
REVISED OCT. 1995

CONWAY TOWNSHIP, T4N, R3E

C-9, CORNER COMMON TO SECTIONS 19, 20, 29 AND 30.

FIELD 6-20-1996 DARRELL D. HUGHES AND ASSOCIATES, FOWLerville.

Found 1" square iron bar, 0.8' below gravel road grade. 4' East of cl Stow Rd., 2' North of cl Sherwood Rd. Witness' agree with other surveyors back to 1972. Measures South to C-10 and West to B-9 agree with past measures. I recommend, to the peer group, approval of the location for C-9. Location OK for GPS.

1825 Sylvester Sibley, Deputy U.S. Surveyor, "North between 29 and 30...80 chains, set post". (P.7-7A)

1872 Miles Bullock survey of Section 19 and Section 29. (P.8-8B)

1972 Steadman uses corner in survey. (P.9)

1972 Garlock uses corner in survey and files Act 74. (P.10-10A)

1976 Piotrowski uses corner in survey. (P.11)

1980 Boss uses corner in survey. (P.12-12A)

1986 Hughes uses corner in survey. (P.13-13A)

1990 Jacobs (JCK Assoc.) survey. (P.14)

1996 Witness comparison list. (P.15)