

LAND CORNER RECORDATION CERTIFICATE  
Filing Requirement of Act 74, Mich. P.A. 1970

9-  
FILED

For corners in

LIVINGSTON  
(County)

Located In:

Corner Code #

1996 NOV 14 P 1:21

NANCY HAVILAND  
REGISTER OF DEEDS  
LIVINGSTON COUNTY, MI.  
48843

L.S.C.#594m

Register of Deeds Stamp & File Number

1. Public Land Survey

T 4N R 3E C-11

T     R        

T     R        

T     R        

2. Property Controlling in Section

S     T     R        

3. Miscellaneous Property in Sec.

S     T     R        

S     T     R        


S     T     R        

4. Lot No. \_\_\_\_\_, Recorded Plat \_\_\_\_\_

5. Private Claims \_\_\_\_\_

I, DARRELL HUGHES, in a field survey on 10-30, 1996 do hereby state that under requirements of P.A. 74, Michigan P.A. of 1970, the corner points mentioned in lines 1 and 2 above were in conformance with regulations and rules therefore as required in the current manual of survey instructions of the United States Department of the Interior, Bureau of Land Management or by a decree of a Court of Law and for that the corner points mentioned in lines 3, 4 and 5 above were in conformance with the rules of the Michigan Board of Land Surveyors or by a Decree of a Court of Law, established, re-established, monumented, recovered, found as expressed below:

NOTE: Not more than 2 corners, all in the same town and range, may be recorded on this certificate.

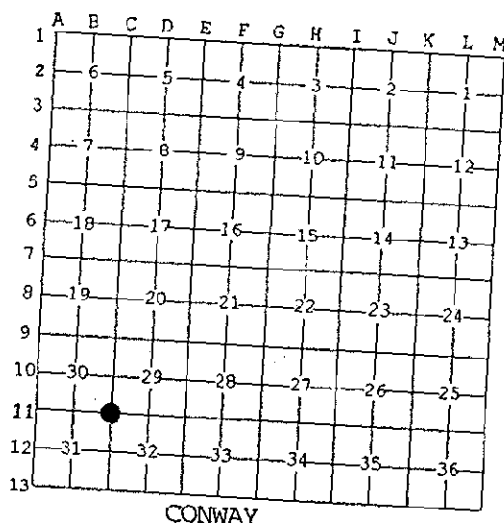

A. Description of original monument and accessories and/or subsequent restoration:  
GLO: 1825  
Linden 8", South 88 degrees West, 9 links  
White Ash 4", North 72 degrees East, 21 links

B. Description of corner evidence found and/or method applied in restoring or reestablishing corner:  
Found 1/2" iron rod

\*Additional descriptions and historical information on back of this sheet.

C. Description of monument for corner and accessories established to perpetuate locating the position of the corner:

C-11, T4N, R3E, CONWAY, replaced existing corner with 1-1/4" X 36" iron pipe, affixed with 2" dia. brass cap, stamped "Livingston Co. Monumentation Corner, P.S. 19834, and is accepted as a careful and faithful perpetuation of the position of the original corner.  
125 DEG. 64.51' SET NAIL/TAG N/S 24" HICKORY.  
286 DEG. 162.46' SET NAIL/TAG S/S UTILITY POLE.  
256 DEG. 166.48' SET NAIL/TAG N/S UTILITY POLE.  
041 DEG. 62.45' SET NAIL/TAG NW/S UTILITY POLE.

Signed by [Signature]  
Surveyor's Michigan License No. 19834

Date October 30, 1996

P.A. 345 1990, APPROVED BY LIVINGSTON COUNTY  
PEER GROUP ON 7-10-96 CO. REP JED

FORM APPROVED BY MICHIGAN STATE BOARD OF PROFESSIONAL SURVEYORS, JAN. 28, 1971  
REVISED MAY 14, 1975  
REVISED JAN, 1983  
REVISED OCT., 1995

CONWAY TOWNSHIP, T4N, R3E

C-11, CORNER COMMON TO SECTIONS 29, 30, 31 AND 32.

FIELD: 6-21-1996 DARRELL D. HUGHES AND ASSOCIATES, FOWLerville.

Found 1/2" iron rod 0.5' below gravel road grade. 8' West of centerline Stow Rd and 2' South of centerline Chase Lake Rd. Iron set by Garlock, April, 1972 by doubling N/S 1/8 line fences to the East. (P.10) This same iron has been used by all surveyors working in area to the present. Measures agree North to C-10 and East to D-11. I recommend, to the peer group, the acceptance of this iron for the position of C-11. Good for GPS, iron near centerline of 4-way intersection.

1825 Sylvester Sibley, Deputy U.S. Surveyor, "North between Sections 31 & 32, -80.00 chains, set post" (P.7-7A)

1872 Miles Bullock, County Surveyor, moves "mile stake". (P.8-8A)

1972 April Garlock sets corner by doubling N/S 1/8 line fences to the East. Files Act 74. (P.10-10A)

1972 May Survey by Garlock uses corner. (P.9)

1974 Garlock uses corner in survey. (P.11)

1973-1974 Boss survey. copies Garlock witness' (P.12-12C)

1975 Piotrowski files Act 74 (P.13)

1977 A.F. Miller performs survey using rerod. (P.14)

1977 Garlock uses corner in survey. (P.15)

1979 Boss surveys 1 mile East in SE 1/4 Sec.29 copies Garlock witness' for this corner. (P.16-16A)

1979 Boss survey (same Garlock witness') P.17

1981 Garlock survey (copies 1972 witness') P.18

1984 Hughes survey, set new witness' P.19

1991 Garlock survey (copies 1972 witness') P.20

1991 Hughes survey, remeasures and sets new witness' P.20A-20B

1991 Garlock survey (copies 1972 witness') P.21

1994 Hughes survey, remeasures witness' P.22-22A

1994 Brewer files Act 74 measures witness' P.23

1994 Hughes survey, remeasures and sets new witness. P.24

1996 Witness comparison list. P.25-25A