

FEB 25 1999

SECTION

LAND CORNER RECORDATION CERTIFICATE
Filing Requirement of Act 74, Mich. P.A. 1970

FILED

For corners in

LIVINGSTON
(County)

Located In:

Corner Code #

1. Public Land Survey

T4N R 3E E10

2. Property Controlling in Section

S T R

3. Miscellaneous Property in Sec.

S T R

91

1998 AUG 20 P 4:45

NANCY HAVILAND
REGISTER OF DEEDS
LIVINGSTON COUNTY, MI.
48843

L.S.C. #879m

Register of Deeds Stamp & File Number


4. Lot No. _____, Recorded Plat _____
5. Private Claims _____

I, CHARLES E GARLOCK, in a field survey on JULY 7, 1998 do hereby state that under requirements of P.A. 74, Michigan P.A. of 1970, the corner points mentioned in lines 1 and 2 above were in conformance with regulations and rules therefore as required in the current manual of survey instructions of the United States Department of the Interior, Bureau of Land Management or by a decree of a Court of Law and/or that the corner points mentioned in lines 3, 4 and 5 above were in conformance with the rules of the Michigan Board of Land Surveyors or by a Decree of a Court of Law, established, re-established, monumented, recovered, found as expressed below:

NOTE: Not more than 2 corners, all in the same town and range, may be recorded on this certificate.

	A	B	C	D	E	F	G	H	I	J	K	L	M
1													
2	6		5		4		3		2		1		
3													
4	7		8		9		10		11		12		
5													
6	18		17		16		15		14		13		
7													
8	19		20		21		22		23		24		
9													
10	30		29		28		27		26		25		
11													
12	31		32		33		34		35		36		
13													

A. Description of original monument and accessories and/or subsequent restoration:
GLO SURVEY DATED: APRIL 15, 1825 BY S SIBLEY, DS
GLO WITNESSES: WO 10-N57½E-20 LKS
BEECH 9-S35W-17 LKS.

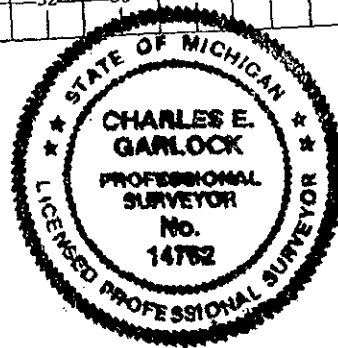

ADDITIONAL DATA ON REAR OF SHEET

B. Description of corner evidence found and/or method applied in restoring or reestablishing corner:
FOUND 1/2" I. ROD OVER 1" I. BAR ABOUT 3.5' DEEP, FENCE AND TREE ROW TO THE EAST.

C. Description of monument for corner and accessories established to perpetuate locating the position of the corner:
E10: E ¼ COR. SEC. 29, T4N-R3E, CONWAY TWP. LIV. CO. MI, RESET FOUND IRONS WITH 1½" X 36" BREAKAWAY I. PIPE WITH LIV. CO. REMON BRASS CAP ON TOP.
N44E-37.88'-SP & TAG W/S 30" OAK
N54E-82.18'-SP & TAG E/S U. POLE
S82E-52.66'-SO & TAG S/S 8" ASH
S37W-91.64'-NE CORNER BARN FOUNDATION
N38W-51.89'-SP & TAG E/S U. POLE

Signed by Charles E. Garlock
Surveyor's Michigan License No. 14762

Date AUGUST 8, 1998

PA. 345 1990, APPROVED BY LIVINGSTON COUNTY
PEER GROUP ON 2/11/98 CO. REP VED