

LAND CORNER RECORDATION CERTIFICATE
Filing Requirement of Act 74, Mich. P.A. 1970

For corners in

<u>Livingston</u> (County)	Located In:	Corner Code #:
1. Public Land Survey	T <u>4N</u> R <u>3E</u>	E-11
	T _____ R _____	_____
	T _____ R _____	_____
	T _____ R _____	_____
2. Property Controlling in Section	S _____ T _____ R _____	_____
	S _____ T _____ R _____	_____
3. Miscellaneous Property in Sec.	S _____ T _____ R _____	_____
	S _____ T _____ R _____	_____

9

FILED

JUN 5 10 30 AM '95

NANCY HAVILLAND
REGISTER OF DEEDS
LIVINGSTON COUNTY, MI
43843

C.L.S.# 405m
Register of Deeds Stamp & File Number

4. Lot No. _____, Recorded Plat _____
 5. Private Claims _____

	A	B	C	D	E	F	G	H	I	J	K	L	M
2	6		5		4		3		2		1		
3													
4	7		8		9		10		11		12		
5													
6	18		17		16		15		14		13		
7													
8	19		20		21		22		23		24		
9													
10	30		29		28		27		26		25		
11													
12	31		32		33		34		35		36		
13													

Charles E Garlock in a field survey on May 22, 1995
 I hereby certify that under requirements of P.A. 74, Michigan P.A. of 1970, the corner points mentioned
 in lines 1 and 2 above were in conformance with regulations and rules therefore as required in the
 current manual of survey instructions of the United States Department of the Interior, Bureau of Land
 Management or by a decree of a Court of Law and/or that the corner points mentioned in lines 3, 4 and 5
 above were in conformance with the rules of the Michigan Board of Land Surveyors or by a Decree of a
 Court of Law; established, re-established, monumented, re-monumented, recovered, found as
 expressed below:


NOTE: Not more than 4 corners, all in the same town and range, may be recorded
 on this certificate.

Description of original monument and accessories and/or subsequent restoration:
 GLO survey dated: April 15, 1825
 GLO witnesses: Tam10-S65E-39 lks
 Tam10-S4½W-34 lks

Additional historical data on rear of sheet.
 Description of corner evidence found and/or method applied in restoring or reestablishing corner:
 Found 1/2" I. Rod at -0.9' raised with a large spike at -0.5' in road intersection of Chase
 Lake and Nicholson Roads.

CONWAY TWP
 REAR OF SHEET
 DWG. 14762

Description of monument for corner and accessories established to perpetuate locating the position of the corner:
 E-11: NW corner Section 33, T4N-R3E, Conway Twp. Liv. Co. MI; reset found items with 1 1/4"
 X 3/8" breakaway I. Pipe with Liv. co. Remon brass cap on top and in a set Mon. Box.
 N40W-64.35'-sp & tag E/s U pole
 N37W-122.55'-sp & tag E/s 9" Elm
 N40E-154.96'-sp & tag W/s 6" Oak
 N45E-130.95'-sp & tag W/s 7" Oak
 N85W-70.63'-ctr. N. end 15" CMP
 S50W-47.25'-ctr. S. end 24" CMP

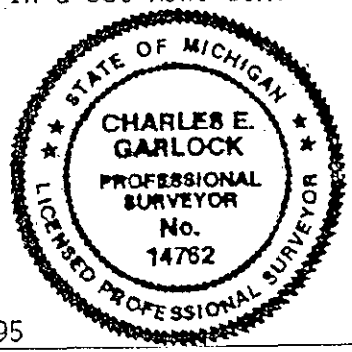

Witnessed by Charles E. Garlock Date May 24, 1995
 Surveyor's Michigan License No. 14762

CORNER SUMMARY

E-11: NW COR. SEC. 33, T4N-R3E, CONWAY TWP. LIV. CO. MI

GLO SURVEY DATED APRIL 15, 1825 BY S SIBLEY AND NONE OF THE GLO WITNESSES REMAIN.


IN 1915 DUNNING SET A 10 1/2" X 9" X 8" STONE IN A PAIL AT THE BOTTOM OF THE HOLE, NEXT ABOVE HE SET ANOTHER STONE, 16 1/2" X 11" X 9" AND ON TOP OF IT A SPADE & SHOVEL FOLLOWED BY BROKEN CROCKERY AND AN OLD TIN PAN. NEXT KNOWN ACTIVITY WAS IN 1974 WHEN BOSS FOUND A 40-60 PENNY SPIKE, LATER IN THE 70'S BENTON CALLED IT AN I. ROD AND SINCE IT HAS BEEN CALLED A SPIKE BY BOSS, DESINE AND HUGHES AS LATE AS 1993. CURRENTLY WE FOUND THE LARGE SPIKE IN CHASE LAKE AND NICHOLSON ROADS IN AN ASPHALT ROAD SURFACE. ONLY TWO WITNESSES REMAIN, ONE BY BOSS (1974) AND ONE BY HUGHES (1989), BOTH CHECK. MEASURES EAST TO THE 1/4 CORNER ARE: 2639.73 BY BENTON, 2639.34 BY DESINE, 2639.36 BY HUGHES AND CURRENTLY 2639.35 BY MYSELF. SOUTH: 2641.61 TO A NAIL BY BENTON (RESET BY 1/2" I. ROD), 2642.10 TO BENTON'S I. ROD BY BOSS, 2641.47 TO A 1/2" I. ROD BY HUGHES (THAT HE SET) AND CURRENTLY I'VE MEASURED, 2641.44 TO A 1/2" I. ROD (BY HUGHES) AND 2642.15 TO A STONE, BENTON'S AND BOSS' I. ROD IS GONE; THE STONE WAS FOUND WHERE THEIR IRON SHOULD HAVE BEEN. FOUND ONE ACT 74 RECORDED IN 1974 BY BOSS AND THREE ACT 132'S RECORDED THAT ARE TIED TO SAID CORNER.

WHEN WE PREPARE TO SET THE REMON. CORNER AND IF DUNNING'S CORNER IS FOUND WE WILL AJUST TO SAME. SITE IS A GOOD GPS STATION.

Charles E. Garlock

CHARLES E. GARLOCK
PS 14762

E11CON95

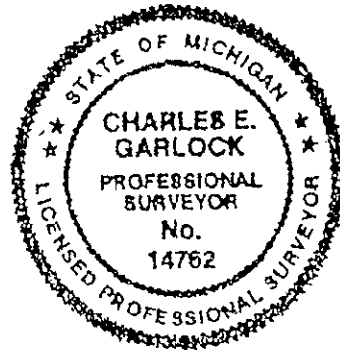

403E E 11

4