

LAND CORNER RECORDATION CERTIFICATE
Filing Requirement of Act 74, Mich. P.A. 1970

91

BARBARA HAVILAN
 REGISTER OF DEEDS
 LIVINGSTON COUNTY, MI
 48843

JUN 5 10 38 AM '95

FILED

or corners in

<u>Livingston</u> (County)	Located In:	Corner Code #
Public Land Survey	T <u>4N</u> R <u>3E</u>	<u>E-12</u>
	T _____ R _____	_____
	T _____ R _____	_____
	T _____ R _____	_____
Property Controlling in Section	S _____ T _____ R _____	_____
Miscellaneous	S _____ T _____ R _____	_____
Property in Sec.	S _____ T _____ R _____	_____

C. L. S. #404m

Register of Deeds Stamp & File Number

Lot No. _____, Recorded Plat _____
 Private Claims _____

Charles E Garlock in a field survey on May 22, 1995, 19_____,
 hereby certify that under requirements of P.A. 74, Michigan P.A. of 1970, the corner points mentioned
 in lines 1 and 2 above were in conformance with regulations and rules therefore as required in the
 current manual of survey instructions of the United States Department of the Interior, Bureau of Land
 Management or by a decree of a Court of Law and/or that the corner points mentioned in lines 3, 4 and 5
 above were in conformance with the rules of the Michigan Board of Land Surveyors or by a Decree of a
 Court of Law; established, re-established, monumented, re-monumented, recovered, found as
 expressed below:

**NOTE: Not more than 4 corners, all in the same town and range, may be recorded
 on this certificate.**

A	B	C	D	E	F	G	H	I	J	K	L	M
2	6	5	4	3	2	1						
3												
4	7	8	9	10	11	12						
5												
6	18	17	16	15	14	13						
7												
8	19	20	21	22	23	24						
9												
10	30	29	28	27	26	25						
11												
12	31	32	33	34	35	36						
13												

Description of original monument and accessories and/or subsequent restoration:

GLO survey dated: April 15, 1825
 GLO witnesses: Aspin7-N42½W-9 lks
 Aspin8-N24½W-10 lks

Additional historical data on rear of sheet

Description of corner evidence found and/or method applied in restoring or reestablishing corner:


Found 1/2" I. Rod thru hole in green stone, stone described by G Dunning in 1915 as the
 corner and set by him, and believed to be the same stone.

RECORDED
 LIVINGSTON COUNTY, MI

001-1995

Description of monument for corner and accessories established to perpetuate locating the position of the corner:

E-12: W 1/4 corner Section 33, T4N-R3E, conway Twp. Liv. Co. MI; reset items found with
 1 1/4" X 36" breakaway I. Pipe with Liv. Co. Remon. brass cap on top at -0.5'
 N85E-184.92'-sp & tag S/s U Pole
 S15W-134.11'-sp & tag E/s 12" Walnut
 S25W-98.53'-sp & tag E/s U. Pole
 N80W-40.50'-sp & tag N/s 7" Walnut
 S55W-149.48'-SE cor. Hse Fdn #6493
 South-5.6'±-ctr. Grant Rd. to East
 on ctr. of Nicholson Rd. N. & S.

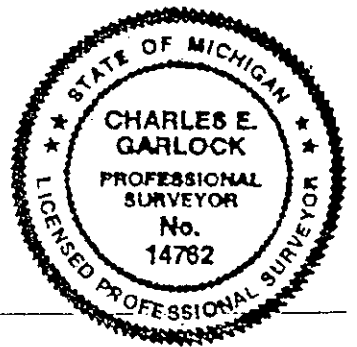

Signed by Charles E. Garlock

Date May 24, 1995

Surveyor's Michigan License No. 14762

FORM APPROVED BY MICHIGAN STATE BOARD OF LAND SURVEYORS, JAN. 28, 1971
 REVISED MAY 14, 1975
 REVISED JAN., 1983

P.A. 345 1990, APPROVED BY LIVINGSTON COUNTY

PEER GROUP ON 3/15/95 CO. REP LED

CORNER SUMMARY

E-12: W 1/4 CORNER SEC. 33, T4N-R3E, CONWAY TWP. LIV. CO. MI

GLO SURVEY DATED APRIL 15, 1825 BY S SIBLEY AND NONE OF THE GLO WITNESSES REMAIN.


E GRANT WITNESSED THE CORNER IN 1877 AND DUNNING 1915, DUNNING CALLED IT A STONE; NONE OF THEIR WITNESSES REMAIN. IN 1975 BENTON SET A 1/2" I. ROD IN PLACE OF A FOUND STEEL CUT NAIL AND IN 1992 BOSS USED THE BENTON POINT FOR ALIGNMENT IN A SURVEY TO THE EAST. IN 1989 HUGHES SET A 1/2" I. ROD IN LINE WITH THE FOUND CENTER OF SECTION AND A FENCE LINE WEST INTO SECTION 32 AND AT A DISTANCE OF 39.88 CHAINS (BULLOCK DISTANCE) FROM THE CENTER OF SECTION (2632.08 FT.). BRADY AND MYSELF USED THE HUGHES IRON IN 1989 AND 90 WHEN THE BENTON IRON WAS NOT FOUND. THE HUGHES IRON IS LOCATED 6.53 FEET WEST OF THE BENTON POINT.

DURING MY RECENT SURVEY FOR REMONUMENTATION I FOUND THE FOLLOWING: HUGHES IRON AND ALL REMAINING WITNESSES BY HUGHES, BRADY AND MYSELF CHECK; NONE OF BENTONS WITNESSES REMAIN. I COMPUTED AN ANGLE AND DISTANCE FROM MY TRAVERSE LINE TO BENTON'S IRON AND FOUND NOTHING OF BENTON'S IRON, BUT AT 12" TO 18" BELOW THE SURFACE OF THE GRAVEL ROADWAY WE FOUND A STONE (DUNNING'S ?) LAYING FLAT THAT MEASURED 12" X 8" X 6". A MEASURE FROM THIS STONE EAST TO THE CENTER OF SECTION IS 2625.67 FT. AND AT 1312.85 FT. (HALFWAY) WE FOUND AN OCCUPATION LINE TO THE NORTH AND A BOSS IRON. THE STONE ALSO LINES WITH THE CENTER OF SECTION AND THE FENCE LINE WEST INTO SEC. 32. DUNNING ALSO NOTED IN 1915 THAT A MIDPOINT BETWEEN THE W 1/4 COR. AND THE NW COR. WAS NEAR THE WEST EDGE OF THE ROAD WHICH STILL HOLDS TRUE. IT IS POSSIBLE THAT SOMEONE BEFORE BENTON FOUND THE STONE AND RAISED IT WITH THE STEEL CUT NAIL ??? THE MEASURES NORTH TO THE NW COR. ARE: 2641.61 BY BENTON, 2642.10 BY BOSS AND 2642.15 BY MYSELF; EAST TO THE CTR. ARE: 2625.48 BY BENTON AND BOSS AND 2625.67 BY MYSELF. SOUTH TO THE SW COR. ARE: 2637.06 BY MYSELF. I WOULD RECOMMEND USING THE FOUND STONE, BECAUSE IT IS NEAR THE SIZE DUNNING HAS USED IN THE SECTION AND IT FITS OCCUPATION SO WELL TO THE EAST AND THE EDGE OF THE ROAD TO THE NORTH. AREA IS OPEN FOR GPS STATION EXCEPT TO THE WEST ALONG THE HEDGE ROW.



CHARLES E GARLOCK
PS 14762

E12CON95

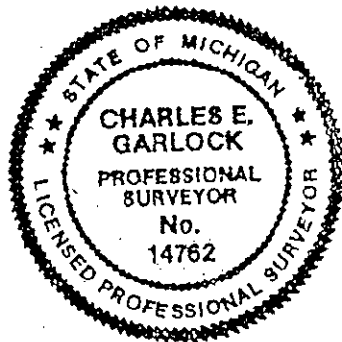

40-3E E12