

JUN 29 1995

COMMISSION

LAND CORNER RECORDATION CERTIFICATE
Filing Requirement of Act 74, Mich. P.A. 1970

APR 26 9 45 AM '95

NANCY HAVILAND
REGISTER OF DEEDS
LIVINGSTON COUNTY, MI
48843

For corners in

Livingston
(County)

Located In:

Corner Code #

- 1. Public Land Survey T 4N R 3E E-13
 T _____ R _____
 T _____ R _____
 T _____ R _____
- 2. Property Controlling S _____ T _____ R _____
 in Section S _____ T _____ R _____
- 3. Miscellaneous S _____ T _____ R _____
 Property in Sec. S _____ T _____ R _____
- 4. Lot No. _____, Recorded Plat _____
- 5. Private Claims _____

L.S.C. #392

Register of Deeds Stamp & File Number

I, Charles E Garlock in a field survey on April 21, 19 95, do hereby certify that under requirements of P.A. 74, Michigan P.A. of 1970, the corner points mentioned in lines 1 and 2 above were in conformance with regulations and rules therefore as required in the current manual of survey instructions of the United States Department of the Interior, Bureau of Land Management or by a decree of a Court of Law and/or that the corner points mentioned in lines 3, 4 and 5 above were in conformance with the rules of the Michigan Board of Land Surveyors or by a Decree of a Court of Law; established, re-established, monumented, re-monumented, recovered, found as expressed below:

	A	B	C	D	E	F	G	H	I	J	K	L	M
2	6	5	4	3	2	1							
3													
4	7	8	9	10	11	12							
5													
6	18	17	16	15	14	13							
7													
8	19	20	21	22	23	24							
9													
10	30	29	28	27	26	25							
11													
12	31	32	33	34	35	36							
13													

NOTE: Not more than 4 corners, all in the same town and range, may be recorded on this certificate.

A. Description of original monument and accessories and/or subsequent restoration:

GLO survey dated: April 15, 1825
GLO witnesses: Elm 9-N82W-20 1/2 lks
Maple 6-N16W-77 lks

Additional historical data on rear of sheet


B. Description of corner evidence found and/or method applied in restoring or reestablishing corner:

Found 1/2" I. rod that had been set by previously setting NW cor. Sec. 4 T3N-R3E at closing distance from W 1/4 cor. Sec. 4 T3N-R3E. Then SW cor. Sec. 33 T4N-R3E was set at GLO jog of 182.82' West of NW cor. Sec. 4 and on line with NW cor. Sec. 4 and S 1/4 cor. Sec. 33 T4N-R3E RE-SET corner by double proportionate distances from W 1/4 corner Sec. 33 of 1334.89' and double proportionate distances from SE cor. of Sec 33 of 2636.55'; said point being on line with the centerline of a very old road bed to the North and 8.5'± South of the very old road bed to the East. Measures West to the South 1/4 corner of Sec. 32 T4N-R3E was 2633.14' and 5266.29' to the SW cor. of Sec. 32

Above 1/2" I. Rod was set by M Brady L.S.C. # 1422

C. Description of monument for corner and accessories established to perpetuate locating the position of the corner:

E-13: SW corner Section 33 T4N-R3E, Conway Twp. Liv. Co. MI. Set 1 1/4" X 36" I. Pipe with Liv. Co. Remon brass cap on top at +0.3'
East-21.26'-sp & tag S/s 8" Ash
S10W-26.61'-sp & tag E/s 15" Ash Set Carsonite post
West-9.37'-sp & tag N/s 40" Maple 0.3'± West of corner
N15W-19.33'-sp & tag E/s 8" Ash
Corner lines with c/l of old road bed to the North
Corner lies 8.5'± South of old road bed to the East.
N26°43'E 37.00 ft. to the found 1/2" I. rod previously set by M Brady L.S.C. #1422

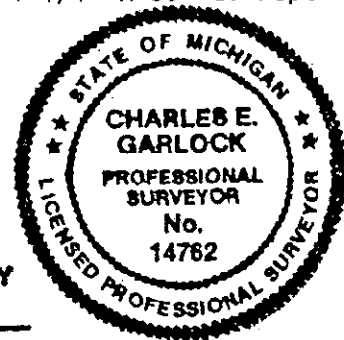

P.A. 345 1990, APPROVED BY LIVINGSTON COUNTY
PEER GROUP ON 4/5/95 CO. REP JED

Signed by Charles E. Garlock Date April 22, 1995

Surveyor's Michigan License No. 14762

CORNER SUMMARY

E-13: SW COR. SEC. 33, T4N-R3E, CONWAY TWP. LIVA CO. MI


GLO SURVEY DATED APRIL 15, 1825 BY S. SIBLEY AND NONE OF THE GLO WITNESSES REMAIN.

FOUND A 1/2" CAPPED I. ROD SET BY M BRADY, SEE LSC # 1422. CORNER WAS ESTABLISHED BY M BRADY BY FIRST SETTING NW CORNER SECTION 4 T3N-R3E AT A GLO CLOSING DISTANCE OF 2059.86 FEET FROM THE WEST 1/4 CORNER OF SECTION 4 AND PROJECTING THE CENTERLINE OF NICHOLSON ROAD NORTH. THEN THE SW CORNER OF SECTION 33 WAS SET AT THE GLO JOG DISTANCE OF 182.82 FEET WEST OF THE NW CORNER OF SECTION 4 AND ON LINE WITH THE NW CORNER OF SECTION 4 AND THE SOUTH 1/4 CORNER OF SECTION 33, CONWAY TWP. FURTHER RESEARCH AND RECON FOUND A 90 DEGREE ANGLE IN A VERY OLD ROAD BED ABOUT 30 FEET SOUTHERLY. THEN BY DOUBLE PROPORTIONATE MEASURES OF 1334.89 FEET SOUTH FROM THE WEST 1/4 CORNER OF SECTION 33 AND DOUBLE PROPORTIONATE MEASURES WEST OF 2636.55 FEET FROM THE SOUTHEAST CORNER OF SECTION 33, WE FOUND SAID POINT FELL ON THE CENTERLINE OF THE OLD ROAD BED TO THE NORTH AND ABOUT 8.5 FEET SOUTH OF THE OLD ROAD BED TO THE EAST. MEASURING WEST THE DISTANCE IS 2633.14 FEET TO THE SOUTH 1/4 CORNER OF SECTION 32 AND CONTINUING ANOTHER 2633.15 FEET TO THE SOUTHWEST CORNER OF SECTION 32, CONWAY TWP. THEREFORE RE-ESTABLISHING THE SOUTHWEST CORNER OF SECTION 33 BY DOUBLE PROPORTIONATE DISTANCES NORTH, EAST AND WEST AND BETTER FITTING THE VERY OLD OCCUPATION CENTERLINE OF A ROAD BED THAT IS NOW ABANDONED. THIS LOCATION IS NOT SUITABLE FOR GPS.

Charles E. Garlock

CHARLES E GARLOCK PS 14762

E13CON95

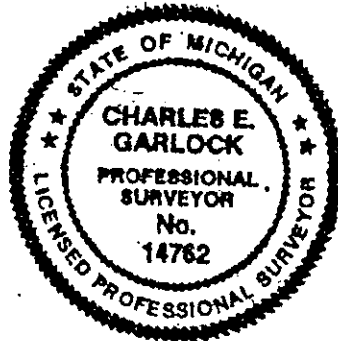

4N-3E E-13

4