

LAND CORNER RECORDATION CERTIFICATE
Filing Requirement of Act 74, Mich. P.A. 1970

For corners in

Livingston
 (County)

Located In:

Corner Code ##

1. Public Land Survey	T <u>4N</u> R <u>3E</u>	<u>F-11</u>
	T _____ R _____	_____
	T _____ R _____	_____
	T _____ R _____	_____
2. Property Controlling in Section	S _____ T _____ R _____	_____
	S _____ T _____ R _____	_____
3. Miscellaneous Property in Sec.	S _____ T _____ R _____	_____
	S _____ T _____ R _____	_____

NANCY HAVILLANT
 REGISTER OF DEEDS
 LIVINGSTON COUNTY, MI
 48843

JUN 5 10 38 AM '95

FILED

C. I. S. #406m
 Register of Deeds Stamp & File Number

4. Lot No. _____, Recorded Plat _____
 5. Private Claims _____

	A	B	C	D	E	F	G	H	I	J	K	L	M
2	5	5	4	3	2								
3													
4	7	8	9	10	11	12							
5													
6	18	17	16	15	14	13							
7													
8	19	20	21	22	23	24							
9													
10	30	29	28	27	26	25							
11													
12	31	32	33	34	35	36							
13													

I, Charles E Garlock, in a field survey on May 22, 1995, do hereby certify that under requirements of P.A. 74, Michigan P.A. of 1970, the corner points mentioned in lines 1 and 2 above were in conformance with regulations and rules therefore as required in the current manual of survey instructions of the United States Department of the Interior, Bureau of Land Management or by a decree of a Court of Law and/or that the corner points mentioned in lines 3, 4 and 5 above were in conformance with the rules of the Michigan Board of Land Surveyors or by a Decree of a Court of Law; established, re-established, monumented, re-monumented, recovered, found as expressed below:

NOTE: Not more than 4 corners, all in the same town and range, may be recorded on this certificate.

A. Description of original monument and accessories and/or subsequent restoration:

GLO survey dated: April 15, 1825
 GLO witnesses: R024-S13½E-37 lks
 R015-N26E-45 lks

Additional historical data on rear of sheet


B. Description of corner evidence found and/or method applied in restoring or reestablishing corner:

Found 1/2" I. rod in centerline of asphalt road and inline with old fence lines to the South and North.

CONWAY TWP
 LIVINGSTON COUNTY, MI
 MAY 24 1995
 CHARLES E. GARLOCK

- Description of monument for corner and accessories established to perpetuate locating the position of the corner:

F-11: North 1/4 corner Section 33, T4N-R3E, Conway Twp. Liv. Co. MI; reset 1/2" I. rod with 1 1/4" X 36" breakaway I. Pipe with Liv. Co. Remon brass cap on top in a set Mon. Box at -0.5'
 North-56.73'-sp & tag E/s 5" Walnut
 S5W-35.83'-sp & tag E/s 18" Oak
 S30E-25.40'-sp & tag NE/s 12" oak!
 S60E-97.88'-sp & tag N/s 10" Elm

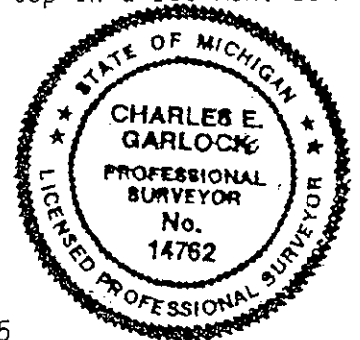

Signed by Charles E. Garlock

Date May 24, 1995

Surveyor's Michigan License No. 14762

FORM APPROVED BY MICHIGAN STATE BOARD OF LAND SURVEYORS, JAN. 28, 1971
 REVISOR MAY 14, 1975
 REVISOR JAN. 1983
 FILED BY 3/1/95

CORNER SUMMARY

F-11: N 1/4 COR. SEC. 33 T4N-R3E, CONWAY TWP. LIV. CO. MI


GLO SURVEY DATED APRIL 15, 1825 BY S SIBLEY AND NONE OF THE GLO WITNESSES REMAIN.

NEXT KNOWN ACTIVITY WAS IN 1872 BY BULLOCK AND 1915 BY DUNNING, NONE OF THEIR WITNESSES REMAIN, BUT BULLOCK REFERS TO IRON AND BRICK FOR THE CORNER. IN 1973 BENTON SET A 1/2" I. ROD ON THE ASPHALT CENTERLINE OF CHASE LAKE RD. AND IN LINE WITH FENCES TO THE NORTH AND SOUTH. SINCE THEN CHMP, DESINE AND HUGHES HAVE USED THIS IRON AND THEIR REMAINING WITNESSES CHECK. MEASURES WEST TO THE SEC. COR. ARE: 2639.73 BY BENTON, 2639.34 BY DESINE, 2639.36 BY HUGHES AND 2639.35 BY MYSELF. TO THE EAST TO THE OTHER SEC. COR. ARE: 2649.17 BY BENTON, 2652.74 BY DESINE AND 2652.51 BY CHMP. SOUTH TO THE CENTER OF SEC. ARE: 2641.49 BY HUGHES, 2641.58 BY BENTON AND 2641.34 BY MYSELF. NO ACT 74 IS RECORDED AND FOUR ACT 132'S TIED TO THIS CORNER ARE RECORDED. TREES LOCATED TO THE SOUTH AND SE'LY OBSTRUCT A GPS SITE.

Charles E. Garlock

CHARLES E GARLOCK
PS 14762

F11CON95

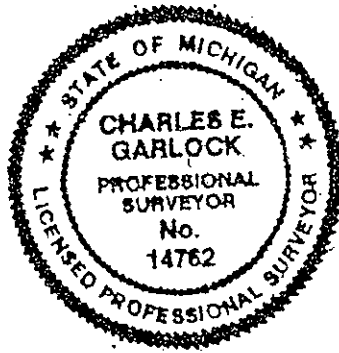

4N3E F11

4