

JUN 29 1995

APR 26 9 45 AM '95

**LAND CORNER RECORDATION CERTIFICATE**  
Filing Requirement of Act 74, Mich. P.A. 1970

NANCY HAVILAND  
REGISTER OF DEEDS  
LIVINGSTON COUNTY, MI  
48843

**COMMISSION**

For corners in

Livingston  
(County)

Located In:

Corner Code ##

- |                                    |                         |             |
|------------------------------------|-------------------------|-------------|
| 1. Public Land Survey              | T <u>4N</u> R <u>3E</u> | <u>F-13</u> |
|                                    | T _____ R _____         | _____       |
|                                    | T _____ R _____         | _____       |
|                                    | T _____ R _____         | _____       |
| 2. Property Controlling in Section | S _____ T _____ R _____ | _____       |
|                                    | S _____ T _____ R _____ | _____       |
| 3. Miscellaneous Property in Sec.  | S _____ T _____ R _____ | _____       |
|                                    | S _____ T _____ R _____ | _____       |

L.S.C. #393  
Register of Deeds Stamp & File Number

4. Lot No. \_\_\_\_\_, Recorded Plat \_\_\_\_\_
5. Private Claims \_\_\_\_\_

	A	B	C	D	E	F	G	H	I	J	K	L	M
2	6	5	4	3	2	1							
3													
4	7	8	9	10	11	12							
5													
6	18	17	16	15	14	13							
7													
8	19	20	21	22	23	24							
9													
10	30	29	28	27	26	25							
11													
12	31	32	33	34	35	36							
13													


I, Charles E Garlock in a field survey on April 21, 19 95, do hereby certify that under requirements of P.A. 74, Michigan P.A. of 1970, the corner points mentioned in lines 1 and 2 above were in conformance with regulations and rules therefore as required in the current manual of survey instructions of the United States Department of the Interior, Bureau of Land Management or by a decree of a Court of Law and/or that the corner points mentioned in lines 3, 4 and 5 above were in conformance with the rules of the Michigan Board of Land Surveyors or by a Decree of a Court of Law; established, re-established, monumented, re-monumented, recovered, found as expressed below:

**NOTE: Not more than 4 corners, all in the same town and range, may be recorded on this certificate.**

- A. Description of original monument and accessories and/or subsequent restoration:  
 GLO survey dated: April 15, 1825 by S Sibley DS  
 GLO witnessess: W036-N76W-6 lks  
Hick 9- N7½E-17½ lks.

Additional historical data on rear of sheet

- B. Description of corner evidence found and/or method applied in restoring or reestablishing corner:  
Found. 3/4" I. Pipe as per 1872 witness by County Surveyor, Miles W Bullock

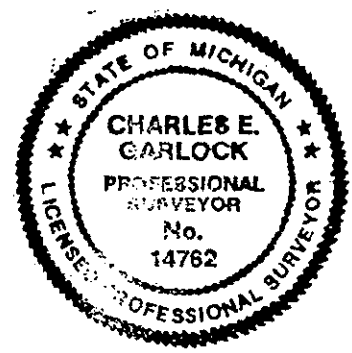

- C. Description of monument for corner and accessories established to perpetuate locating the position of the corner:  
F-13: South 1/4 corner Section 33, T4N-R3E, Conway Twp. Liv. Co. MI; reset 3/4" I. Pipe with 1 1/4" X 36" breakaway I. Pipe with Liv. Co. Remon cap on top at -0.5'  
South-32.93'-sp & tag W/s 20" Hickory  
N20E-131.43'-sp & tag W/s 30" Hickory  
N10W-154.40'-sp & tag E/s 26" Hickory  
S45W-83.55'-sp & tag NW/s U. Pole  
South-5.1'±-c/l Allen Road  
East-9.65'±-c/l Miller Road

**P.A. 345 1990, APPROVED BY LIVINGSTON COUNTY**  
 PEER GROUP ON 3/1/95 CO. REP JED

igned by Charles E. Garlock

Date April 22, 1995

urveyor's Michigan License No. 14762

CORNER SUMMARY

F-13: S 1/4 COR. SEC. 33 T4N-R3E, CONWAY TWP. LIV. CO. MI


GLO SURVEY DATED APRIL 15, 1825 BY S SIBLEY AND NONE OF THE GLO WITNESSES REMAIN.

M BULLOCK WITNESSED THIS CORNER IN 1872 TO AN 8" HICKORY , SOUTH, 50 LKS (33.00 FT.) AND IN 1989 M BRADY FOUND A 3/4" I. PIPE THAT MEASURED 32.96 FT., SOUTH TO A 24" HICKORY AND BARNWELL IN 1992 ALSO FOUND THE 3/4" I. PIPE AND THE REMAINING WITNESSES BY BRADY AND BARNWELL CHECK. THE GLO DISTANCE EAST TO THE HANDY CORNER WAS 170.61 FT. AND IT NOW MEASURES 170.60 FT. IRON IS LOCATED 5 FT. NORTH OF ALLEN RD. AND 9 FT. W. OF MILLER RD. MEASURES NORTH TO THE CENTER OF SECTION ARE: 2665.34 BY BRADY AND 2665.61 BY MYSELF CURRENTLY. WEST TO THE SECTION CORNER: 2620.03 BY BRADY AND 2620.12 BY MYSELF. FOUND ONE ACT 74 RECORDED BY BARNWELL IN 1992 AND THREE ACT 132'S RECORDED. ONLY OBSTRUCTION FOR GPS IS THE HICKORY TREE TO THE SOUTH.



CHARLES E. GARLOCK  
PS 14762

F13CON95

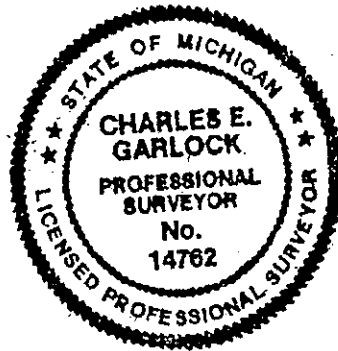

T4N-R3E  
F13

5