

SURVEY & REMONUMENTATION

FEB 25 1999

LAND CORNER RECORDATION CERTIFICATE
Filing Requirement of Act 74, Mich. P.A. 1970

FILED

For corners in

SECTION

<u>LIVINGSTON</u> (County)	Located In:	Corner Code #
1. Public Land Survey	T4N R 3E	G10
	T R	
	T R	
	T R	
2. Property Controlling in Section	S T R	
	S T R	
3. Miscellaneous Property in Sec.	S T R	
	S T R	

9/

1998 AUG 20 P 4:45

NANCY HAVILAND
REGISTER OF DEEDS
LIVINGSTON COUNTY, MI.
48843

L.S.C. #883m

Register of Deeds Stamp & File Number


4. Lot No. _____, Recorded Plat _____
5. Private Claims _____

I, CHARLES E GARLOCK, in a field survey on JULY 8, 1998 do hereby state that under requirements of P.A. 74, Michigan P.A. of 1970, the corner points mentioned in lines 1 and 2 above were in conformance with regulations and rules therefore as required in the current manual of survey instructions of the United States Department of the Interior, Bureau of Land Management or by a decree of a Court of Law and/or that the corner points mentioned in lines 3, 4 and 5 above were in conformance with the rules of the Michigan Board of Land Surveyors or by a Decree of a Court of Law; established, re-established, monumented, recovered, found as expressed below:

NOTE: Not more than 2 corners, all in the same town and range, may be recorded on this certificate.

	A	B	C	D	E	F	G	H	I	J	K	L	M
1													
2	6		5		4		3		2		1		
3													
4	7		8		9		10		11		12		
5													
6	10		17		16		15		14		13		
7													
8	19		20		21		22		23		24		
9													
10	30		29		28		27		26		25		
11													
12	31		32		33		34		35		36		
13													

A. Description of original monument and accessories and/or subsequent restoration:
GLO SURVEY DATED: APRIL 15, 1825 BY S SIBLEY, DS
GLO WITNESSES: B ASH 9-S70E-45 LKS
B ASH 12-N24W-20 LKS.

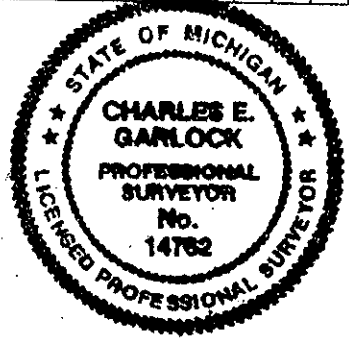

ADDITIONAL DATA ON REAR OF SHEET.

B. Description of corner evidence found and/or method applied in restoring or reestablishing corner:
FOUND 3/4" I. PIPE BENT TO NORTH, TREE ROW TO THE WEST, NOTHING TO THE EAST

C. Description of monument for corner and accessories established to perpetuate locating the position of the corner:
G10: E 1/4 COR. SEC. 28, T4N-R3E, CONWAY TWP. LIV. CO. MI, RESET 3/4" I. PIPE WITH 1 1/4" X 36" I. PIPE WITH BREAKAWAY TOP AND LIV. CO. REMON BRASS CAP ON TOP.
N20E-95.19'-SP & TAG W/S 24" OAK
WEST-34.63'-SP & TAG W/S 7" OAK
N46E-37.80'-SP & TAG W/S 12" DBL. ELM
S45E-44.35'-SP & TAG W/S 7" ASH

Signed by Charles E. Garlock
Surveyor's Michigan License No. 14762

Date JULY 20, 1998

P.A. 345 1990, APPROVED BY LIVINGSTON COUNTY
PEER GROUP ON 2/11/98 CO. REP. JED