

REMONUMENTATION CORNER UNDER ACT 345, MICHIGAN PUBLIC ACTS OF 1990

**FILED**

**LAND CORNER RECORDATION CERTIFICATE**

Filing Requirement of Act 74, Mich. P.A. 1970

For corners in

LIVINGSTON  
(County)

Located In:

Corner Code #

		4N	3E	G-13
1. Public Land Survey	T	_____	R	_____
	T	_____	R	_____
	T	_____	R	_____
	T	_____	R	_____
2. Property Controlling in Section	S	_____	T	_____
	S	_____	T	_____
3. Miscellaneous Property in Sec.	S	_____	T	_____
	S	_____	T	_____

Nov 10 8 14 AM '94

HANCOCK HAVILAND  
REGISTER OF DEEDS  
LIVINGSTON COUNTY, MI  
48843

L.S.C.#275m  
Register of Deeds Stamp & File Number

4. Lot No. \_\_\_\_\_, Recorded Plat \_\_\_\_\_  
5. Private Claims \_\_\_\_\_

Donald G. Richards

I, \_\_\_\_\_, in a field survey on August 13th, 1994

do hereby certify that under requirements of P.A. 74, Michigan P.A. of 1970, the cornerpoints mentioned in lines 1 and 2 above were in conformance with regulations and rules therefore as required in the current manual of survey instructions of the United States Department of the Interior, Bureau of Land Management or by a decree of a Court of Law and/or that the corner points mentioned in lines 3, 4 and 5 above were in conformance with the rules of the Michigan Board of Land Surveyors or by a Decree of a Court of Law; established, re-established, monumented, re-monumented, recovered, found as expressed below:

**NOTE: Not more than 4 corners, all in the same town and range, may be recorded on this certificate.**


	A	B	C	D	E	F	G	H	I	J	K	L	M
2	6		5		4		3		2		1		
3													
4	7		8		9		10		11		12		
5													
6	18		17		16		15		14		13		
7													
8	19		20		21		22		23		24		
9													
10	30		29		28		27		26		25		
11													
12	31		32		33		34		35		36		
13													

A. Description of original monument and accessories and/or subsequent restoration:

"West 80.00 (chains) set post corner to Sections 33 & 34  
Tamarack 10 N 32 E 7 1/2  
Tamarack 18 N 21 1/2 W 82"  
Joseph Wampler, February 14th, 1824

B. Description of corner evidence found and/or method applied in restoring or reestablishing corner:

Found 1/2" iron rered  
(see reverse side for research and investigation summary)

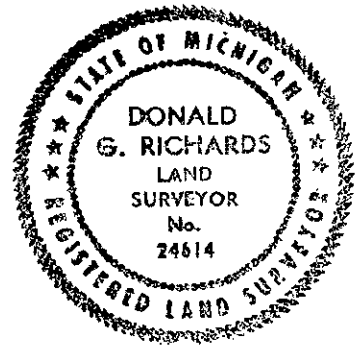

C. Description of monument for corner and accessories established to perpetuate locating the position of the corner:

Reset with 1 1/4" x 36" iron pipe w/brass cap stamped "Livingston County Monumentation Corner" and "24614"

S 75 W 87.62' 1" iron witness pipe w/brass cap\*  
S 65 E 34.97' 1" iron witness pipe w/brass cap\*  
N 40 E 74.62' 1" iron witness pipe w/brass cap\*  
N 20 W 60.99' 1" iron witness pipe w/brass cap\*  
EAST 171.64' northwest corner Sec. 3, T3N-R3E (found 1/2" rered)  
\*caps read "Livingston County Remonumentation Witness" and are stamped "24614"

*[Signature]*  
DONALD G. RICHARDS

(approved by peer group 9-28-94)

Signed by \_\_\_\_\_ Date October 22, 1994

Surveyor's Michigan License No. 24614