

MAR 17 2000

SECTION

LAND CORNER RECORDATION CERTIFICATE
Filing Requirement of Act 74, Mich. P.A. 1970

FILED

For corners in

LIVINGSTON
(County)

Located In:

Corner Code #

- 1. Public Land Survey T 4N R 3E K8
 T _____ R _____
 T _____ R _____
 T _____ R _____
- 2. Property Controlling S _____ T _____ R _____
 in Section S _____ T _____ R _____
- 3. Miscellaneous S _____ T _____ R _____
 Property in Sec. S _____ T _____ R _____

1999 JUN -4 P 12: 56

NANCY HAVILAND
REGISTER OF DEEDS
LIVINGSTON COUNTY, MI.
48843

L.S.C. #1035m
Register of Deeds Stamp & File Number

- 4. Lot No. _____, Recorded Plat _____
- 5. Private Claims _____

	A	B	C	D	E	F	G	H	I	J	K	L	M
2	6		5		4		3		2		1		
3													
4	7		8		9		10		11		12		
5													
6	18		17		16		15		14		13		
7													
8	19		20		21		22		23		24		
9													
10	30		29		28		27		26		25		
11													
12	31		32		33		34		35		36		
13													

CHARLES E GARLOCK in a field survey on MARCH 18, 19 99, do hereby certify that under requirements of P.A. 74, Michigan P.A. of 1970, the corner points mentioned in lines 1 and 2 above were in conformance with regulations and rules therefore as required in the current manual of survey instructions of the United States Department of the Interior, Bureau of Land Management or by a decree of a Court of Law and/or that the corner points mentioned in lines 3, 4 and 5 above were in conformance with the rules of the Michigan Board of Land Surveyors or by a Decree of a Court of Law; established, re-established; monumented, re-monumented, recovered, found as expressed below:

NOTE: Not more than 4 corners, all in the same town and range, may be recorded on this certificate.

A. Description of original monument and accessories and/or subsequent restoration:

GLO SURVEY DATED: APRIL 15, 1825 BY S SIBLEY AND NONE OF THE GLO WITNESSES REMAIN.
GLO WITNESSES: W027'S70E-13.20'
BEECH 10-7.92'S86W


B. Description of corner evidence found and/or method applied in restoring or reestablishing corner:

FOUND 1/2" I. ROD IN GRAVEL ROAD N-S AND FENCE LINE TO THE EAST

P.A. 345 1990, APPROVED BY LIVINGSTON COUNTY
PEER GROUP ON 2-3-1999 CO. REP JED

C. Description of monument for corner and accessories established to perpetuate locating the position of the corner:

K8: W 1/4 COR. SEC. 24 T4N-R3E, CONWAY TWP. LIV. CO. MI. RESET IRON WITH 1 1/4" X 36" BREAK-AWAY IRON PIPE WITH LIV. CO. BRASS CAP #14762
S27E-149.12'-SP & TAG W/S U. POLE
S88E-24.27'-SP & TAG 48" OAK
N60W-46.67'-SP & TAG N/S 8" SPRUCE
N 21W-63.95'-SP 7 TAG E/S 16" OAK
N13W-119.52'- SP & TAG E/S 24" OAK

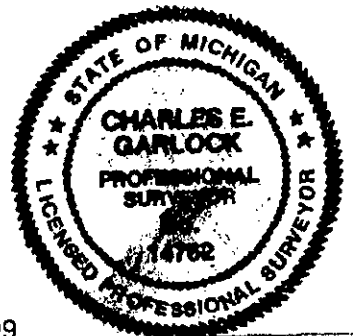

Signed by Charles E. Garlock

Date MARCH 19, 1999

Surveyor's Michigan License No. 14762