

MAR 17 2000

SECTION

LAND CORNER RECORDATION CERTIFICATE  
Filing Requirement of Act 74, Mich. P.A. 1970

FILED

For corners in  
LIVINGSTON

(County)

Located In:

Corner Code ##

1. Public Land Survey	T <u>4N</u> R <u>3E</u>	<u>K9</u>
	T _____ R _____	_____
	T _____ R _____	_____
	T _____ R _____	_____
2. Property Controlling in Section	S _____ T _____ R _____	_____
	S _____ T _____ R _____	_____
3. Miscellaneous Property in Sec.	S _____ T _____ R _____	_____
	S _____ T _____ R _____	_____

1999 JUN -4 P 12:56

NANCY HAVILAND  
REGISTER OF DEEDS  
LIVINGSTON COUNTY, MI.  
48843

L.S.C. #1036m

Register of Deeds Stamp & File Number

- 4. Lot No. \_\_\_\_\_, Recorded Plat \_\_\_\_\_
- 5. Private Claims \_\_\_\_\_

A	B	C	D	E	F	G	H	I	J	K	L	M
2	6	5	4	3	2	1						
3												
4	7	8	9	10	11	12						
5												
6	18	17	16	15	14	13						
7												
8	19	20	21	22	23	24						
9												
10	30	29	28	27	26	25						
11												
12	31	32	33	34	35	36						
13												

I, CHARLES E GARLOCK, in a field survey on MARCH 17, 1999, do hereby certify that under requirements of P.A. 74, Michigan P.A. of 1970, the corner points mentioned in lines 1 and 2 above were in conformance with regulations and rules therefore as required in the current manual of survey instructions of the United States Department of the Interior, Bureau of Land Management or by a decree of a Court of Law and/or that the corner points mentioned in lines 3, 4 and 5 above were in conformance with the rules of the Michigan Board of Land Surveyors or by a Decree of a Court of Law; established, re-established, monumented, re-monumented, recovered, found as expressed below:


**NOTE: Not more than 4 corners, all in the same town and range, may be recorded on this certificate.**

A. Description of original monument and accessories and/or subsequent restoration:  
 GLO SURVEY DATED: APRIL 15, 1825 BY S SIBLEY AND NONE OF THE GLO WITNESSES REMAIN.  
 GLO WITNESSES: IRONWOOD 7-N41E-7.26'  
 HICKORY 8-S10E-8.58'

B. Description of corner evidence found and/or method applied in restoring or reestablishing corner:  
 FOUND 1/2" I. ROD AT INTERSECTION OF GRAVEL ROADS.

PA. 345 1990, APPROVED BY LIVINGSTON COUNTY  
 PEER GROUP ON 2-3-1999 CO. REP JED

C. Description of monument for corner and accessories established to perpetuate locating the position of the corner:  
 K9: SW COR. SEC. 24 T4N-R3E, CONWAY TWP. LIV. CO. MI. RESET WITH 1 1/4" X 36" BREAKAWAY IRON PIPE WITH LIVINGSTON STD. BRASS CAP #14762  
 SOUTH 1'-C/L SHERWOOD ROAD  
 EAST-4'-C/L ROBB ROAD  
 S60W-40.92'-SP & TAG N/S 18" MAPLE  
 N74W-72.80'-SP & TAG N/S 12" HICKORY  
 N40W-52.05'-SP & TAG S/S U. POLE  
 N43E-77.34'-SP & TAG S/S U. POLE

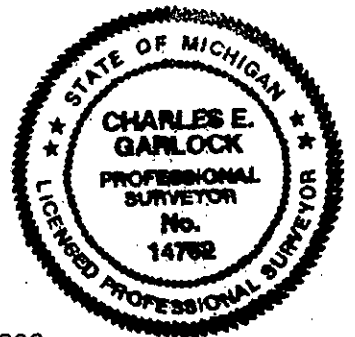

Signed by Charles E. Garlock

Date MARCH 19, 1999

Surveyor's Michigan License No. 14762