

MAR 17 2000

SECTION

LAND CORNER RECORDATION CERTIFICATE
Filing Requirement of Act 74, Mich. P.A. 1970

FILED

For corners in

<u>LIVINGSTON</u> (County)	Located In:	Corner Code #
1. Public Land Survey	<u>T4N R3E</u>	<u>L-07</u>
	T ___ R ___	_____
	T ___ R ___	_____
	T ___ R ___	_____
2. Property Controlling in Section	S ___ T ___ R ___	_____
	S ___ T ___ R ___	_____
3. Miscellaneous Property in Sec.	S ___ T ___ R ___	_____
	S ___ T ___ R ___	_____

1999 JUN -4 P 12: 56

NANCY HAVILAND
REGISTER OF DEEDS
LIVINGSTON COUNTY, MI.
48843

L.S.C. #1038m

Register of Deeds Stamp & File Number

4. Lot No. _____, Recorded Plat _____
5. Private Claims _____

I, CHARLES E. GARLOCK, in a field survey on MARCH 22, 1999 do hereby state that under requirements of P.A. 74, Michigan P.A. of 1970, the corner points mentioned in lines 1 and 2 above were in conformance with regulations and rules therefore as required in the current manual of survey instructions of the United States Department of the Interior, Bureau of Land Management or by a decree of a Court of Law and/or that the corner points mentioned in lines 3, 4 and 5 above were in conformance with the rules of the Michigan Board of Land Surveyors or by a Decree of a Court of Law; established, re-established, monumented, recovered, found as expressed below:

NOTE: Not more than 2 corners, all in the same town and range, may be recorded on this certificate.

1	A	B	C	D	E	F	G	H	I	J	K	L	P
2		6		5		4		3		2		1	
3													
4		7		8		9		10		11		12	
5													
6		16		17		16		15		14		13	
7													
8		19		20		21		22		23		24	
9													
10		30		29		28		27		26		25	
11													
12		31		32		33		34		35		36	
13													

A. Description of original monument and accessories and/or subsequent restoration:

GLO 1825 SIBLEY SET POST
BLACK OAK 7 N 81 E 28.4'
TAMARAC 11 S 55 1/2 W 28.7'

B. Description of corner evidence found and/or method applied in restoring or reestablishing corner:

FOUND A 1/2" REROD WITH A. F. MILLER CAP IN FENCE NORTH SOUTH AND WEST. THIS POSITION IS THE ONLY ONE THAT APPEARS TO HAVE BEEN USED.

C. Description of monument for corner and accessories established to perpetuate locating the position of the corner:

L-07 SOUTH 1/4 CORNER SECTION 13, NORTH 1/4 CORNER SECTION 24, T4N, R3E, CONWAY TOWNSHIP, LIVINGSTON COUNTY, MICHIGAN:


SET 1 1/4" X 36" STEEL PIPE WITH LIVINGSTON COUNTY REMONUMENTATION BRASS CAP WITH SURVEYOR #14762 @ 1/2 FOOT ABOVE THE SURFACE OF SURROUNDING GROUND (PLACED OVER EXISTING 1/2" REROD).

EAST NAIL WITH LIVINGSTON COUNTY REMON TAG IN SOUTH SIDE 8" ASH	3.18'
SOUTH NAIL WITH LIVINGSTON COUNTY REMON TAG IN EAST SIDE 30" MAPLE	28.99'
S60°W NAIL WITH LIVINGSTON COUNTY REMON TAG IN NORTH SIDE 36" OAK	45.08'
N85°W NAIL WITH LIVINGSTON COUNTY REMON TAG IN SOUTH SIDE 10" CHERRY	33.13'

Signed by Charles E. Garlock Date 3-25-99

Surveyor's Michigan License No. 14762

P.A. 345 1990, APPROVED BY LIVINGSTON COUNTY PEER GROUP ON 2-3-1999 CO. REP JED

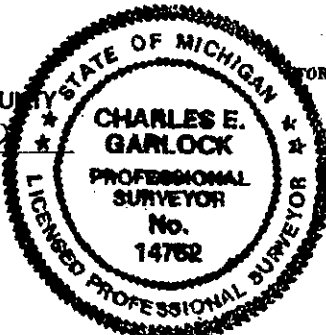

FORM APPROVED BY MICHIGAN STATE BOARD OF PROFESSIONAL SURVEYORS, JAN. 21
REVISED MAY 14, 1975 REVISED JAN, 1983
REVISED OCT, 1995