

MAR 17 2000

SECTION

LAND CORNER RECORDATION CERTIFICATE  
Filing Requirement of Act 74, Mich. P.A. 1970

FILED

For corners in  
LIVINGSTON

(County)

Located In:

Corner Code ##

- 1. Public Land Survey      T 4N R 3E      L9  
                                   T    R  
                                   T    R  
                                   T    R
- 2. Property Controlling    S    T    R  
    in Section               S    T    R
- 3. Miscellaneous           S    T    R  
    Property in Sec.         S    T    R

1999 JUN -4 P 12: 57

NANCY HAVILAND  
REGISTER OF DEEDS  
LIVINGSTON COUNTY, MI.  
48843

L.S.C. #1039m

Register of Deeds Stamp & File Number

- 4. Lot No. \_\_\_\_\_, Recorded Plat \_\_\_\_\_
- 5. Private Claims \_\_\_\_\_

	A	B	C	D	E	F	G	H	I	J	K	L	M
2	6	5	4	3	2								
3													
4	7	8	9	10	11	12							
5													
6	18	17	16	15	14	13							
7													
8	19	20	21	22	23	24							
9													
10	30	29	28	27	26	25							
11													
12	31	32	33	34	35	36							
13													

CHARLES E. GARLOCK, in a field survey on MARCH 17, 19 99, do hereby certify that under requirements of P.A. 74, Michigan P.A. of 1970, the corner points mentioned in lines 1 and 2 above were in conformance with regulations and rules therefore as required in the current manual of survey instructions of the United States Department of the Interior, Bureau of Land Management or by a decree of a Court of Law and/or that the corner points mentioned in lines 3, 4 and 5 above were in conformance with the rules of the Michigan Board of Land Surveyors or by a Decree of a Court of Law; established, re-established, monumented, re-monumented, recovered, found as expressed below:


**NOTE: Not more than 4 corners, all in the same town and range, may be recorded on this certificate.**

A. Description of original monument and accessories and/or subsequent restoration:

GLO SURVEY DATED: APRIL 15, 1825 BY S SIBLEY AND NONE OF THE GLO WITNESSES REMAIN.  
 GLO WITNESSES: TAM 9-S60W- 5.94'  
                           TAM 10-8.58'-NORTH

B. Description of corner evidence found and/or method applied in restoring or reestablishing corner:

FOUND 1/2" I. ROD 7.5' leg. SOUTH OF CENTERLINE OF GRAVEL ROAD E & W AND OCCUPATION NORTH & SOUTH

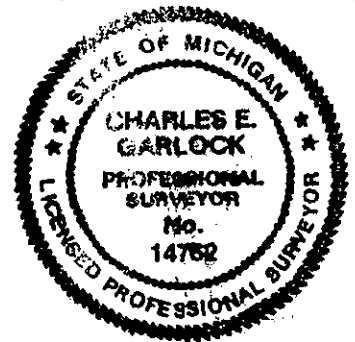

C. Description of monument for corner and accessories established to perpetuate locating the position of the corner:

L9: S 1/4 COR. SEC. 24 T4N-R3E, CONWAY TWP. LIV. CO. MI. RESET IRON ROD WITH 1 1/4" X 36" I. PIPE WITH BREAKAWAY TOP AND LIV. CO. STD. BRASS CAP #14762  
 NORTH 7.5'- C/L SHERWOOD ROAD  
 NORTH-119.18'-SP & TAG W/S U. POLE  
 S18W-18.92'-SP & TAG W/S U. POLE  
 N65E-74.83'-SP SP. & TAG S/S 16" PIGNUT HICKORY  
 S20E-22.05'-C/L 3" PINE  
 WEST-19.0-C/L DRIVEWAY SOUTH

PA. 345 1990, APPROVED BY LIVINGSTON COUNTY  
 PEER GROUP ON 2-3-1999 CO. REP VED

Signed by Charles E. Garlock  
 Surveyor's Michigan License No. 14762

Date MARCH 19, 1999