

1993

COMMISSION

LAND CORNER RECORDATION CERTIFICATE DEC 22 @ 24 AM '93
Filing Requirement of Act 74, Mich. P.A. 1970

NANCY HAVILAND
REGISTER OF DEEDS
LIVINGSTON COUNTY, MI
48843

For corners in

LIVINGSTON
(County)

Located In:

Corner Code ##

1. Public Land Survey	T	4N	R	3E	L-11
	T		R		
	T		R		
	T		R		
2. Property Controlling in Section	S		T	R	
	S		T	R	
3. Miscellaneous Property in Sec.	S		T	R	
	S		T	R	

L.S.C.# 61m

Register of Deeds Stamp & File Number

- 4. Lot No. _____, Recorded Plat _____
- 5. Private Claims _____

A	B	C	D	E	F	G	H	I	J	K	L	M
2	6	5	4	3	2	1						
3												
4	7	8	9	10	11	12						
5												
6	16	17	16	15	14	13						
7												
8	19	20	21	22	23	24						
9												
10	30	29	28	27	26	25						
11												
12	31	32	33	34	35	36						
13												

I, Donald G. Richards, in a field survey on October 19, 1993, do hereby certify that under requirements of P.A. 74, Michigan P.A. of 1970, the corner points mentioned in lines 1 and 2 above were in conformance with regulations and rules therefore as required in the current manual of survey instructions of the United States Department of the Interior, Bureau of Land Management or by a decree of a Court of Law and/or that the corner points mentioned in lines 3, 4 and 5 above were in conformance with the rules of the Michigan Board of Land Surveyors or by a Decree of a Court of Law; established, re-established, monumented, re-monumented, recovered, found as expressed below:

NOTE: Not more than 4 corners, all in the same town and range, may be recorded on this certificate.

A. Description of original monument and accessories and/or subsequent restoration:


Sylvester Sibley, February 18th, 1825
"West 39.85 (chains) set post on true line for 1/4 Section corner
A white Oak 20 N 38 1/2 W 21
A White Oak 11 S 63 E 21"

B. Description of corner evidence found and/or method applied in restoring or reestablishing corner:

Found 1/2" Iron Rod
(see reverse side for research and investigation summary)

C. Description of monument for corner and accessories established to perpetuate locating the position of the corner:

Re-set with 1 1/4" x 36" iron pipe w/brass cap stamped "Livingston County Remonumentation Corner"
S 60 W 71.79' nail/LCWT* in N face 6" Hickory
N 50 W 55.15' nail/LCWT in NE face twin 12" Elm
N 15 E 36.12' nail/LCWT in W face 23" Hickory
S 55 E 51.59' nail/LCWT in N face 16" Ash
(* Livingston County Witness Tag)

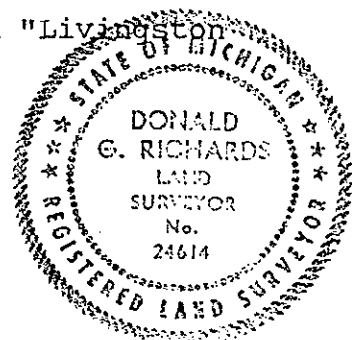

Signed by DONALD G. RICHARDS Date December 10, 1993

Surveyor's Michigan License No. 24614
APPROVED by Livingston County Monumentation Peer Group 11-10-93

CONWAY L-11

This quarter corner was first set by Deputy Surveyor Sylvester Sibley on February 18th, 1825. No county surveyors records were furnished us relating to this point.

In the modern era, a survey by Boss Engineering first identifies the corner and provides three witnesses in 1972. These witnesses were carried forward through the mid-70's and used on LSC 1013 by Karol R. Piotrowski late in 1975. Two years later, A.F. Miller confirms, more or less, two of these witnesses and establishes a new one.

In mid-1980, Darrell Hughes confirms the original two witnesses dating back to Boss'72, does not mention Miller's new witness, but instead establishes a new third tie.

A comparison of distances along the North Section line indicates that this point has not substantively shifted since Boss's Certified Land Survey 815 recorded in 1972.

On October 19, 1993 fieldcrews recovered a 1/2" Iron rod at this corner. Additionally, two witnesses dating to Boss'74, and one witness from Hughes'80 was recovered. Surveys by by Boss'72 & '73, Miller'75, and Hughes'80 indicate this point has not shifted relative to corner K-11 and M-11 in the last two decades.

Donald G. Richards PS 24614
October 22, 1993