

SURVEY & REMONUMENTATION

JUL 16 1997

9

LAND CORNER RECORDATION CERTIFICATE
Filing Requirement of Act 74, Mich. P.A. 1970

FILED

COMMISSION

For corners in

<u>Livingston</u> (County)	Located In:	Corner Code #
1. Public Land Survey	T <u>4N</u> R <u>3E</u>	<u>M-2</u>
	T <u> </u> R <u> </u>	<u> </u>
	T <u> </u> R <u> </u>	<u> </u>
	T <u> </u> R <u> </u>	<u> </u>
2. Property Controlling in Section	S <u> </u> T <u> </u> R <u> </u>	<u> </u>
	S <u> </u> T <u> </u> R <u> </u>	<u> </u>
3. Miscellaneous Property in Sec.	S <u> </u> T <u> </u> R <u> </u>	<u> </u>
	S <u> </u> T <u> </u> R <u> </u>	<u> </u>

1997 MAY 27 P 3:40

NANCY HAVILAND
REGISTER OF DEEDS
LIVINGSTON COUNTY, MI.
48843

L.S.C. #659m

Register of Deeds Stamp & File Number

4. Lot No. _____, Recorded Plat _____
5. Private Claims _____

	A	B	C	D	E	F	G	H	I	J	K	L	M
1													
2	6		5		4		3		2		1		
3													
4	7		8		9		10		11		12		
5													
6	18		17		16		15		14		13		
7													
8	19		20		21		22		23		24		
9													
10	30		29		28		27		26		25		
11													
12	31		32		33		34		35		36		
13													

CHARLES E GARLOCK, in a field survey on MAY 19, 1997 do hereby state that under requirements of P.A. 74, Michigan P.A. of 1970, the corner points mentioned in lines 1 and 2 above were in conformance with regulations and rules therefore as required in the current manual of survey instructions of the United States Department of the Interior, Bureau of Land Management or by a decree of a Court of Law and/or that the corner points mentioned in lines 3, 4 and 5 above were in conformance with the rules of the Michigan Board of Land Surveyors or by a Decree of a Court of Law; established, re-established, monumented, recovered, found as expressed below:

NOTE: Not more than 2 corners, all in the same town and range, may be recorded on this certificate.

A. Description of original monument and accessories and/or subsequent restoration:

GLO SURVEY DATED APRIL 15, 1825 BY S SIBLEY AND NONE OF THE GLO WITNESSES REMAIN
GLO WITNESSES: WO 14-S53W-60 LKS
 W016-N29W-L LK

ADDITIONAL HISTORICAL DATA ON REAR OF SHEET

B. Description of corner evidence found and/or method applied in restoring or reestablishing corner:


FOUND 1/2" I. ROD IN CENTERLINES OF ROADS NORTH, SOUTH AND WEST, ALL KNOWN WITNESSES CHECKED

C. Description of monument for corner and accessories established to perpetuate locating the position of the corner:

M-2: EAST 1/4 COR. SEC. 1 T4N-R3E CONWAY TWP. LIV. COUNTY MICHIGAN, RESET FOUND IRON WITH 1 1/4" X 36" BREAKAWAY I. PIPE WITH LIV. CO. REMON. BRASS CAP ON TOP AT -0.5'
N21E-98.70'-SP & TAG W/S U. POLE
S14E-71.43'-SP & TAG W/S 50" OAK
S58W-54.86'-SP & TAG N/S 15" SPRUCE
N72W-101.57'-SP & TAG S/S U. POLE
N48E-46.97'-SP & TAG NW/S 36" OAK
S50E-106.85'-NW COR. HSE. FDN.
S65W-137.14'-NE COR. HSE FDN.
GLO JOG COMPUTES 14.19' S., FD. NOTHING

Signed by Charles E. Garlock
Surveyor's Michigan License No. 14762

Date MAY 20,

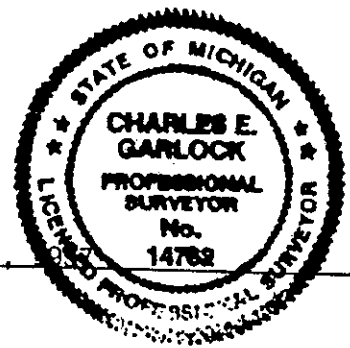

PA. 345 1980, APPROVED BY LIVINGSTON COUNTY
PEER GROUP ON 2/5/97 CO. REP JED

"Be Sure of Your Ground"

CHARLES E. GARLOCK

PROFESSIONAL SURVEYOR


705 N. MICHIGAN AVE.

HOWELL, MICHIGAN 48843

OFFICE: (517) 546-3340

FAX: 517 546-2941

DEC. 28, 1996

 

CORNER SUMMARY

M-2: E 1/4 COR. SEC. 1 T4N-R3E, CONWAY TWP. LIV. CO. MI

GLO SURVEY DATED APRIL 15, 1825 BY S. SIBLEY AND NONE OF THE GLO WITNESSES REMAIN.

I. TELLER IN 1877 WITNESSED THIS CORNER AND TREE IS GONE. NEXT KNOWN ACTIVITY WAS IN 1972 WHEN BOSS ENGR. FOUND A 1/2" I. ROD, FOLLOWED BY GARLOCK IN 1976, AF MILLER IN 1977, CHMP 1981 AND D HUGHES IN 1989, ALL USING THE SAME 1/2" I. ROD. REMAINING WITNESSES OF THE ABOVE SURVEYORS CHECK TO THE FOUND IRON THAT IS LOCATED ON THE CENTERLINE OF ROADS NORTH, SOUTH AND WEST. PIOTROWSKI IN 1973 AND RL SMITH IN 1979 USED THIS CORNER FOR THE W 1/4 COR. IN COHOCTAH TWP., BUT GLO JOG COMPUTES TO A POINT 14.19 FEET TO THE SOUTH. A SEARCH OF THE AREA DID NOT TURN UP ANY OTHER IRONS. THE LAND IN COHOCTAH TWP. IS OWNED BY THE SAME PARTY IN BOTH QUARTERS AND NO OCCUPATION IS TO BE FOUND TO THE EAST. MEASURE SOUTH BY I TELLER IN 1877 WAS 2648.58 FEET AND OUR MEASURE NOW IS 2647.07 FEET. HUGHES, CHMP AND AMERICAN CIVIL ENGRS. ALL MEASURED 2640.90' BUT TO A DIFFERENT IRON. CORNER IS LOCATED IN A GRAVEL ROAD "T" INTERSECTION AND IS A GOOD POINT FOR A GPS STATION.

I RECOMMEND THE FOUND 1/2" I ROD AS THE CORRECT CORNER.

CHARLES E GARLOCK, PS
CON97M2

SUCCESSOR TO:

MILES W. BULLOCK, L.S. (1844 TO 1926)

GRANT H DUNNING, P.E. (1865 TO 1928)

CLAY W. GORDON, RLS (1883 TO 1970)

LYLE W. MUNSELL, RLS (1904 TO 1987)

4405