

JUL 16 1997

COMMISSION

LAND CORNER RECORDATION CERTIFICATE
Filing Requirement of Act 74, Mich. P.A. 1970

FILED

For corners in

<u>LIVINGSTON</u> (County)	Located in:	Corner Code #
1. Public Land Survey	T <u>4N</u> R <u>3E</u>	<u>M-4</u>
	T _____ R _____	_____
	T _____ R _____	_____
	T _____ R _____	_____
2. Property Controlling in Section	S _____ T _____ R _____	_____
	S _____ T _____ R _____	_____
3. Miscellaneous Property in Sec.	S _____ T _____ R _____	_____
	S _____ T _____ R _____	_____

1997 MAY 27 P 3:40

NANCY HAVILAND
REGISTER OF DEEDS
LIVINGSTON COUNTY, MI.
48843

L.S.C.#66 1m

Register of Deeds Stamp & File Number

4. Lot No. _____, Recorded Plat _____
5. Private Claims _____

I, CHARLES E GARLOCK, in a field survey on MAY 19, 1997 do hereby state that under requirements of P.A. 74, Michigan P.A. of 1970, the corner points mentioned in lines 1 and 2 above were in conformance with regulations and rules therefore as required in the current manual of survey instructions of the United States Department of the Interior, Bureau of Land Management or by a decree of a Court of Law and/or that the corner points mentioned in lines 3, 4 and 5 above were in conformance with the rules of the Michigan Board of Land Surveyors or by a Decree of a Court of Law; established, re-established, monumented, recovered, found as expressed below:

NOTE: Not more than 2 corners, all in the same town and range, may be recorded on this certificate.

1	A	B	C	D	E	F	G	H	I	J	K	L	M
2		6		5		4		3		2		1	
3													
4		7		8		9		10		11		12	
5													
6		18		17		16		15		14		13	
7													
8		19		20		21		22		23		24	
9													
10		30		29		28		27		26		25	
11													
12		31		32		33		34		35		36	
13													

A. Description of original monument and accessories and/or subsequent restoration:

GLO SURVEY DATED APRIL 15, 1825 BY S SIBLEY AND NONE OF GLO WITNESSES REMAIN
GLO WITNESSES: SET POST ON RAISED MOUND IN WATER 2 FT. DEEP. NO BEARING TREES.

ADDITIONAL DATA ON REAR OF SHEET

B. Description of corner evidence found and/or method applied in restoring or reestablishing corner:


FD. NOTHING BUT WITNESSES BY OTHERS MADE A TIGHT TRIANGLE ABOUT 3' NORTH OF A BRIDGE, POINT WAS WITHIN 0.28 FT. OF 1/2 DISTANCE BETWEEN SEC. CORNERS.

C. Description of monument for corner and accessories established to perpetuate locating the position of the corner:

M-4: E 1/4 COR. OF SEC. 12, T4N-R3E, CONWAY TWP. LIV. CO. MI, SET 1 1/4" X 36" I. PIPE AT 1/2 DISTANCE BETWEEN SECTION CORNERS, I. PIPE WAS BREAKAWAY WITH LIV. CO. REMON. CAP ON TOP
N35E-58.80'-SP & TAG W/S 12" POPLAR
S65E-11.61'-PK & TAG TOP OF N. END CONCRETE BRIDGE RAILING
S15E-28.79'-PK & TAG TOP OF S. END CONCRETE BRIDGE RAILING
S26W-28.11'-PK & TAG TOP OF S. END CONCRETE BRIDGE RAILING
S75W-9.93'-PK & TAG TOP OF N. END CONCRETE BRIDGE RAILING
SOUTH-3.05'-N. EDGE OF BRIDGE DECK, CONCRETE.
GLO JOG IS 10.56' TO SOUTH WHICH IS IN CTR. OF BRIDGE, NOTHING FD.

Signed by Charles E. Garlock
Surveyor's Michigan License No. 14762

Date MAY 20, 1997

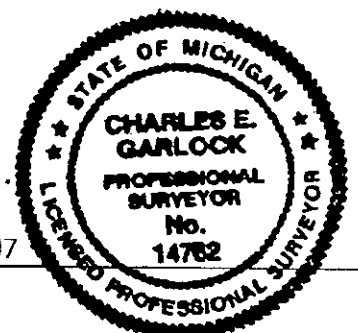

CHARLES E. GARLOCK

PROFESSIONAL SURVEYOR


705 N. MICHIGAN AVE.

HOWELL, MICHIGAN 48843

OFFICE: (517) 546-3340

FAX: 517 546-2941

DECEMBER 28, 1996

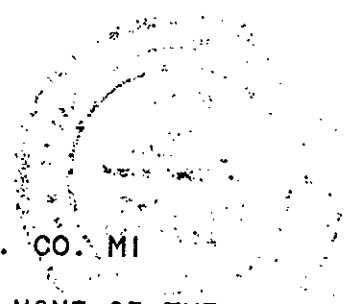

CORNER SUMMARY

M-4: E 1/4 COR. SECTION 12, T4N-R3E, CONWAY TWP. LIV. CO. MI

GLO SURVEY DATED APRIL 15, 1825 BY S. SIBLEY, DS, AND NONE OF THE GLO WITNESSES REMAIN.

IN 1979 ROWE ENGR. SET A 1/2" I. ROD JUST NORTH OF THE NORTH ABUTMENT ON A SMALL CONCRETE BRIDGE SPANNING A SMALL CREEK AND ALL OF THEIR WITNESSES CROSS TO FORM A SMALL TRIANGLE BUT THE IRON IS GONE. WITNESSES BY BOSS DO NOT MATCH ANY TREES PRESENT NOR IS THERE AN IRON 103.18 FEET NORTH FOR THE W 1/4 COR. IN COHOCTAH TWP. GLO JOG IS SOUTH 10.56 FEET WHICH FALLS ON THE APPROXIMATE CENTERLINE OF SAID SMALL CREEK. GLO NOTES FURTHER SAID "A POST WAS SET ON A RAISED MOUND IN 2 FEET OF WATER (CREEK???) , NO BEARING TREES". WE MEASURED NORTH 2644.73 FEET AND SOUTH 2644.17 FEET TO SECTION CORNERS. ROWE ENGR. MEASURED NORTH AND SOUTH 2652.75 FEET TO SECTION CORNERS BUT NOT THE SAME SECTION CORNERS. SITE IS GOOD FOR GPS BUT ROAD AND BRIDGE ARE NARROW AT THIS POINT. NO OCCUPATION TO THE WEST. I RECOMMEND SETTING THE CORNER AT 1/2 DISTANCE BETWEEN SECTION CORNERS AND ON THE SAME LINE ROWE ENGR. USED WHICH WOULD MOVE THE CORNER 0.28 FOOT NORTH OF THE WITNESSED LOCATION BY ROWE ENGR.

CHARLES E GARLOCK, PS
CON97M4

4N3E, M4

4

SUCCESSOR TO:

- MILES W. BULLOCK, L.S. (1844 TO 1926) ● GRANT H DUNNING, P.E. (1865 TO 1928)
- CLAY W. GORDON, RLS (1889 TO 1970) ● LYLE W. MUNSELL, RLS (1904 TO 1987)