

**SURVEY & REMONUMENTATION**

JUL 16 1997

9

COMMISSION

**LAND CORNER RECORDATION CERTIFICATE**  
Filing Requirement of Act 74, Mich. P.A. 1970

**FILED**

For corners in

LIVINGSTON  
(County)

Located In:

Corner Code #

- 1. Public Land Survey      T 4N R 3E      M-8  
    T    R  
    T    R  
    T    R
- 2. Property Controlling    S    T    R  
    in Section                S    T    R
- 3. Miscellaneous            S    T    R  
    Property in Sec.         S    T    R

1997 MAY 27 P 3:40

NANCY HAVILAND  
REGISTER OF DEEDS  
LIVINGSTON COUNTY, MI.  
48843

L.S.C.#665m

Register of Deeds Stamp & File Number

- 4. Lot No. \_\_\_\_\_, Recorded Plat \_\_\_\_\_
- 5. Private Claims \_\_\_\_\_

I, CHARLES E GARLOCK, in a field survey on MAY 20, 1997 do hereby state that under requirements of P.A. 74, Michigan P.A. of 1970, the corner points mentioned in lines 1 and 2 above were in conformance with regulations and rules therefore as required in the current manual of survey instructions of the United States Department of the Interior, Bureau of Land Management or by a decree of a Court of Law and /or that the corner points mentioned in lines 3, 4 and 5 above were in conformance with the rules of the Michigan Board of Land Surveyors or by a Decree of a Court of Law; established, re-established, monumented, recovered, found as expressed below:

**NOTE:** Not more than 2 corners, all in the same town and range, may be recorded on this certificate.

	A	B	C	D	E	F	G	H	I	J	K	L	M
1													
2	6		5		4		3		2		1		
3													
4	7		8		9		10		11		12		
5													
6	18		17		16		15		14		13		
7													
8	19		20		21		22		23		24		
9													
10	30		29		28		27		26		25		
11													
12	31		32		33		34		35		36		
13													

**A. Description of original monument and accessories and/or subsequent restoration:**  
 GLO SURVEY DATED APRIL 15, 1825 BY S SIBLEY AND NONE OF THE GLO WITNESSES REMAIN  
 GLO WITNESSES: W09-N52E-44 LKS  
 B012-S6W-62 LKS


ADDITIONAL DATA ON REAR OF SHEET

**B. Description of corner evidence found and/or method applied in restoring or reestablishing corner:**  
 FD. 1/2" I. ROD W/ D ROSS CAP & BELOW FD. A 1 1/4" I. PIPE 48" LONG, RUSTED AND FD. BRICK

**C. Description of monument for corner and accessories established to perpetuate locating the position of the corner:**  
 M-8: E 1/4 COR. SEC. 24 T4N-R3E CONWAY TWP. LIV. CO. MI, REPLACED ABOVE WITH 1 1/4" X 36" BREAKAWAY I. PIPE W/LIV. CO. REMON BRASS CAP ON TOP AT -0.5'  
 S36W-101.57'-SP & TAG NW/S OF N. U POLE  
 S72W-55.73'-SP & TAG S/S 9" BIRCH  
 N64W-48.55'-SP & TAG N/S 22" MAPLE  
 N20W-66.67'-SP & TAG NE/S 24" FORKED MAPLE  
 N24E-52.45'-SP & TAG W/S 20" FORKED W CHERRY  
 WEST-1'-C/L N-S ROAD  
 SOUTH 22.41'-1/4 COR. FOR T4N-R4E

Signed by Charles E. Garlock  
 Surveyor's Michigan License No. 14762

Date MAY 20, 1997

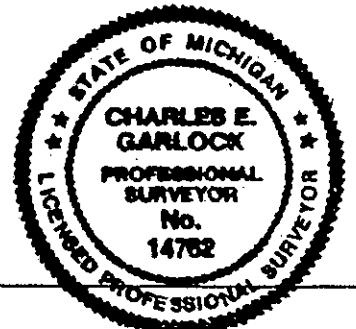

"Be Sure of Your Ground"

**CHARLES E. GARLOCK**

PROFESSIONAL SURVEYOR

705 N. MICHIGAN AVE.

HOWELL, MICHIGAN 48843

OFFICE: (517) 546-3340

FAX: 517 546-2941

DECEMBER 30, 1996

**CORNER SUMMARY**

GLO SURVEY DATED APRIL 15, 1825 BY S SIBLEY, DS, AND NONE OF THE GLO WITNESSES REMAIN.

CONSUMERS POWER FOUND A 1/2" I. PIPE AND RAISED IT WITH A "T" IRON ABOUT 1970, JACK ALBRIGHT FOUND THE "T" IRON IN 1972, NEWTON FOUND A "T" IN AN IRON PIPE, BOSS FOUND AN IRON IN 1986 AND THOMPSON IN 1992 FOUND A 1/2" I. ROD IN A 1" I. PIPE. THE 1/2" I. ROD REPLACED A BENT "T" THAT D ROSS HAD FOUND BEFORE B THOMPSON. ALL THE REMAINING WITNESSES OF THE ABOVE SURVEYORS CHECKED TO THE FOUND 1/2" I. ROD WITH A ROSS CAP. IN 1985 I FOUND AND USED A 5/8" I. ROD LOCATED 22.41 FEET SOUTH OF THE ABOVE IRON, CALLED IT M-8, BUT USED IT FOR ALIGNMENT ONLY. PRESENTLY WE FOUND THE 1/2" I. ROD WITH THE ROSS CAP, IT LINES WITH AN OLD FENCE LINE TO THE WEST AND ALSO TO AN OLD FENCE LINE TO THE EAST. THE GLO JOG CALCS THAT THE CORNER TO THE EAST TOWNSHIP SHOULD BE LOCATED 8.91 FEET SOUTH OF M-8. AN ACT 74 WAS RECORDED BY THOMPSON. WE MEASURED NORTH 2639.82 AND BOSS HAD 2639.77; SOUTH WE MEASURED 2662.29 TO A FOUND BUGGY AXLE, CANTOR MEASURED 2661.29 AND THOMPSON 2662.62 FEET TO A 1/2" I. ROD. SITE IS GOOD FOR A GPS STATION. RECOMMEND WE USE THE FOUND 1/2" I. ROD WITH ROSS CAP OVER AN I. PIPE AS THE CORRECT CORNER.

CHARLES E GARLOCK, PS

00N97M8

4/3E

MB

4

SUCCESSOR TO:

MILES W. BULLOCK, L.S. (1844 TO 1928)

GRANT H DUNNING, P.E. (1865 TO 1926)

CLAY W. GORDON, RLS (1863 TO 1970)

LYLE W. MUNSELL, RLS (1904 TO 1987)